

NEWTON  
 F 2033  
 8/23/79

MISSISSIPPI  
 BOARD OF WATER COMMISSIONERS  
 416 North State Street  
 Jackson, Mississippi 39201

WATER WELL DRILLERS LOG

8-23-1979 McDonald & Hill Farm Newton  
 date well completed firm name county well located

LANDOWNER: Jimmy Coker  
 1320 44th Ave  
 Million Miss  
 (mailing address)

WELL LOCATION:  
 sec. 2 T 7 N R 11 E  
 S W  
 4 miles NORTH of Hickory  
 (distance) (direction) (nearest town)

WELL PURPOSE: home  
 (home, irrigation, municipal, industrial)

WELL COMPLETION DATA:

(1) diameter (inches) 4"

(2) total depth (feet) 260

(3) static water level (feet) 66 below above top of ground.

(4) casing 4" PVC 67' (material) (depth)

(size) if telescope see back.

(5) screen (length) (depth to top)

(size) (material)

(6) pump 10 (HP) (yield gpm)

(type power)

(7) electric log (yes or no)

(organization running log)

(8) how well bottom plugged opened

description of formations encountered	from	to
Clay + sand	0	30
Sandy st shale	30	58
Shale	58	82
Sandy st Rock	82	110
green sand	110	125
Rock + shale	125	240
Coarse sand	240	260


Miss. Board of Water Comm.

AUG 27 1979

DRILLERS REMARKS: None

If well telescopes please sketch and show depths.

GROUND LEVEL

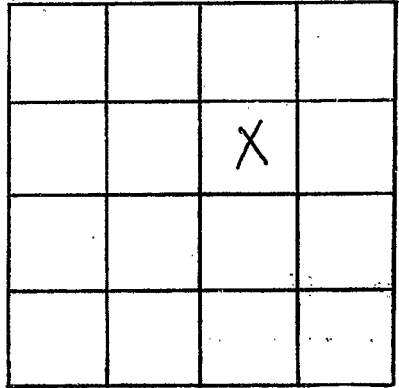

SECTION 2

Please indicate well location X.

ADDITIONAL INFORMATION

If more than one screen, show locations of each on sketch.