

Newtown
Pa 34
1-11-79

MISSISSIPPI
 BOARD OF WATER COMMISSIONERS
 416 North State Street
 Jackson, Mississippi 39201

WATER WELL DRILLERS LOG

1-11-79
 date well completed

McDonally Well
 firm name

Newtown
 county well located

LANDOWNER:	description of formations encountered	from	to
<u>Calhoun Davis</u>	<u>clay & sand</u>	<u>0</u>	<u>40</u>
<u>Rt #1 Decatur</u> (mailing address)	<u>sandy shale</u>	<u>40</u>	<u>90</u>
WELL LOCATION: sec. <u>15</u> T. <u>7</u> N. <u>W</u> R. <u>11</u> E. <u>3</u> miles <u>W</u> of <u>Decatur</u> (distance) (direction) (nearest town)	<u>shale & sand</u>	<u>90</u>	<u>140</u>
	<u>sand</u>	<u>140</u>	<u>225</u>
	<u>sandy shale</u>	<u>225</u>	<u>250</u>
WELL PURPOSE: <u>home</u> (home; irrigation, municipal, industrial)	<u>shale</u>	<u>250</u>	<u>285</u>
WELL COMPLETION DATA:	<u>Rock & shells</u>	<u>285</u>	<u>305</u>
(1) diameter (inches) <u>4"</u>	<u>green, sandy & sandy</u>	<u>305</u>	<u>320</u>
(2) total depth (feet) <u>320'</u>	<u>shale</u>		
(3) static water level (feet) <u>170'</u> below top of ground.			
(4) casing <u>PVC</u> , <u>260'</u> (material) (depth) <u>4"</u> if telescope see back. (size)			
(5) screen _____ (length) (depth to top) (size) (material)			
(6) pump <u>3/4</u> <u>60 gpm</u> (HP) (field gpm) <u>F</u> (type power)			
(7) electric log <u>~</u> (yes or no) (organization running log)			
(8) how well bottom plugged <u>open</u>			
DRILLERS REMARKS:			


DEPT. OF NATURAL RESOURCES
 BUREAU OF LAND & WATER RESOURCES

NOV - 5 1979

RECEIVED

If well telescopes please sketch and show depths.

GROUND LEVEL

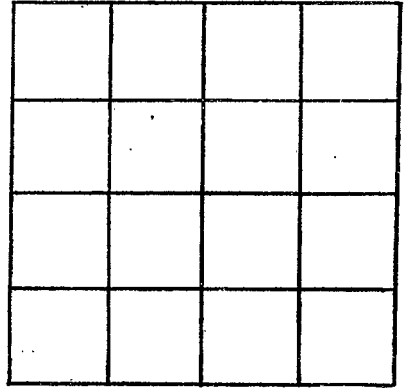

SECTION _____

Please indicate well location X.

ADDITIONAL INFORMATION

If more than one screen,
show locations of each on sketch.