

Newton
F235
11-2-79
11-2-79

MISSISSIPPI
BOARD OF WATER COMMISSIONERS
416 North State Street
Jackson, Mississippi 39201

WATER WELL DRILLERS LOG

19 McDonalds Well Newton
date well completed firm name county well located

LANDOWNER:	description of formations encountered	from	to
<u>Ernest Bryan</u>	<u>clay</u>	<u>0</u>	<u>8</u>
<u>Rt # 1, Decatur</u> (mailing address)	<u>sand</u>	<u>8</u>	<u>35</u>
WELL LOCATION: sec. <u>13</u> T. <u>7</u> N. R. <u>11</u> E <u>1/2</u> miles N. of <u>Decatur</u> (distance) (direction) (nearest town)	<u>sandy shale</u>	<u>35</u>	<u>60</u>
	<u>shale</u>	<u>60</u>	<u>93</u>
	<u>Rock & shells</u>	<u>93</u>	<u>120</u>
WELL PURPOSE: <u>home</u> (home, irrigation, municipal, industrial)	<u>green sand</u>	<u>120</u>	<u>130</u>
WELL COMPLETION DATA:	<u>Rock & shale</u>	<u>130</u>	<u>137</u>
(1) diameter (inches) <u>4"</u>	<u>white sand</u>	<u>137</u>	<u>150</u>
(2) total depth (feet) <u>150'</u>			
(3) static water level (feet) <u>32'</u> below top of ground.			
(4) casing <u>PVC</u> , <u>90'</u> (material) (depth) <u>4"</u> (size) if telescope see back.			
(5) screen _____ (length) (depth to top) (size) (material)			
(6) pump <u>1/2</u> <u>10 gpm</u> (HP) (yield/gpm) <u>F</u> (type power)			
(7) electric log _____ (yes or no) (organization running log)			
(8) how well bottom plugged <u>open</u>			
DRILLERS REMARKS:			


DEPT. OF NATURAL RESOURCES
BUREAU OF LAND & WATER RESOURCES

NOV 13 1979

RECEIVED

If well telescopes please sketch and show depths.

GROUND LEVEL

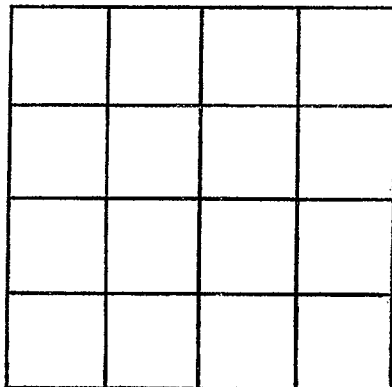

SECTION _____

Please indicate well location X.

ADDITIONAL INFORMATION

If more than one screen,
show locations of each on sketch.