

NEWTON  
F 2037  
11-15-80

MISSISSIPPI  
BOARD OF WATER COMMISSIONERS  
416 North State Street  
Jackson, Mississippi 39201

WATER WELL DRILLERS LOG

11-15 1980 *Ermas Drilling Newton*  
date well completed firm name county well located

LANDOWNER: *Best Vine Church*

*Signature R.H. MS*

(mailing address)


WELL LOCATION:  
sec. 13 T. 70 N. R. 11 E  
S W  
9 miles 5 of Union  
(distance) (direction) (nearest town)

WELL PURPOSE: *Corusck*  
(home, irrigation, municipal, industrial)

WELL COMPLETION DATA:

- (1) diameter (inches) 4 1/2
- (2) total depth (feet) 390
- (3) static water level (feet) 123 below above top of ground.
- (4) casing PVC 300  
(material) (depth)  
(size) If telescope see back.
- (5) screen None  
(length) (depth to top)  
(size) (material)
- (6) pump 7 1/2 10  
(HP) (yield gpm)  
Electric  
(type power)
- (7) electric log 910  
(yes or no)  
(organization running log)
- (8) how well bottom plugged open


description of formations encountered	from	to
<i>Clay</i>	0	20
<i>Red Clay</i>	20	40
<i>" "</i>	40	60
<i>" "</i>	60	70
<i>Clay &amp; sand</i>	70	80
<i>" "</i>	80	140
<i>" "</i>	140	148
<i>Very Sticky Clay</i>	148	162
<i>" "</i>		
<i>Sand</i>	162	230
<i>Rock &amp; Clay</i>	230	242
<i>Red Rock hidden</i>		
<i>" "</i>		
<i>Clay</i>	242	262
<i>" "</i>	262	265
<i>Clay</i>	265	272
<i>Shell &amp; Clay</i>	272	310
<i>Marine Shell</i>	310	358
<i>Sand &amp; silt</i>	358	390

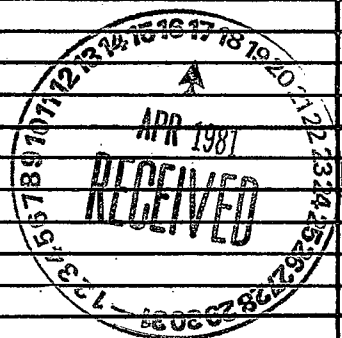

DRILLERS REMARKS:  
*Open Bottom*

If well telescopes please sketch and show depths.

GROUND LEVEL

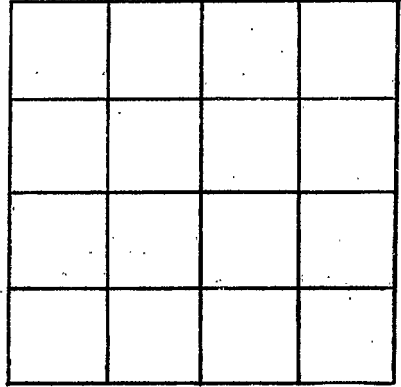

SECTION \_\_\_\_\_

Please indicate well location X.

ADDITIONAL INFORMATION

If more than one screen, show locations of each on sketch.