

MISSISSIPPI DEPARTMENT OF NATURAL RESOURCES

Bureau of Land and Water Resources

Southport Mall

P.O. Box 10631

Jackson, Mississippi 39209

WATER WELL DRILLERS LOG

Newton
F 2039
7/16/81

7-16-81
date well completed

McDonald & Hill Newton
firm name county well located

LANDOWNER:
A. P. Scoggins
Rt # 1 Decatur
(mailing address)


WELL LOCATION:
sec. 36 T 2 N R 11 E
S
2 miles 5 of Decatur
(distance) (direction) (nearest town)

WELL PURPOSE: Home
(home, irrigation, municipal, industrial)

WELL COMPLETION DATA:

- (1) diameter (inches) 4"
- (2) total depth (feet) 300'
- (3) static water level (feet) 165' below above top of ground.
- (4) casing PVC, 220'
(material) (depth)
4" if telescope see back.
(size)
- (5) screen —, —
(length) (depth to top)
(size) (material)
- (6) pump 3/4, 800M
(HP) (yield gpm)
F
(type power)
- (7) electric log —
(yes or no)
(organization running log)
- (8) how well bottom plugged open


| description of formations encountered | from | to |
|---------------------------------------|------|-----|
| clay | 0 | 20 |
| shale | 20 | 25 |
| clay & sand | 25 | 35 |
| shale | 35 | 45 |
| sand | 45 | 100 |
| sand & shale | 100 | 160 |
| lignite | | |
| sandy shale | 160 | 200 |
| shale | 200 | 235 |
| Rock & shells | 235 | 262 |
| green sand & sandy shale | 262 | 280 |
| Rock & shale & sand | 280 | 300 |

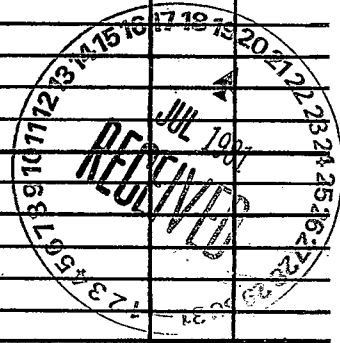

DRILLERS REMARKS:

If well telescopes please sketch and show depths.

GROUND LEVEL

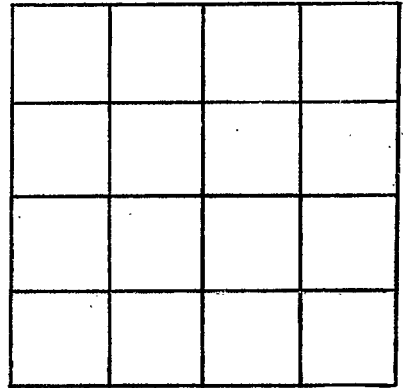

SECTION _____

Please indicate well location X.

ADDITIONAL INFORMATION

If more than one screen,
show locations of each on sketch.