

Newton  
F R  
2040

MISSISSIPPI  
 BOARD OF WATER COMMISSIONERS  
 416 North State Street  
 Jackson, Mississippi 39201

WATER WELL DRILLERS LOG

3-1-82 19 General Drilling Service Newton  
 date well completed firm name county well located

LANDOWNER: C. R. Edwards  
Rt 1 Ducture  
MS  
 (mailing address)

WELL LOCATION:  
 sec 10 T 7 N R 11 E  
4 miles N.W. of Ducture  
 (distance) (direction) (nearest town)

WELL PURPOSE: HOME  
 (home, irrigation, municipal, industrial)

- WELL COMPLETION DATA:
- diameter (inches) 4"
  - total depth (feet) 240
  - static water level (feet) 80 below above top of ground.
  - casing PVC 160'  
 (material) (depth)  
 (size) if telescope see back.
  - screen MSW  
 (length) (depth to top)  
 (size) (material)
  - pump 3/4 10  
 (HP) (yield gpm)  
E  
 (type power)
  - electric log NO  
 (yes or no)  
 (organization running log)
  - how well bottom plugged \_\_\_\_\_


description of formations encountered	from	to
<u>Clay + sand</u>	<u>0</u>	<u>20</u>
<u>Dark clay</u>	<u>20</u>	<u>40</u>
<u>Sand</u>	<u>40</u>	<u>90</u>
<u>Sand</u>	<u>90</u>	<u>98</u>
<u>Clay ledge</u>	<u>98</u>	<u>100</u>
<u>Very coarse sand</u>	<u>100</u>	<u>122</u>
<u>Dark sand + bed</u>	<u>122</u>	<u>142</u>
<u>Clay</u>	<u>142</u>	<u>160</u>
<u>Shell + Rock</u>	<u>160</u>	<u>200</u>
<u>Sand</u>	<u>200</u>	<u>240</u>

DRILLERS REMARKS:

DEPT. OF NATURAL RESOURCES  
 BUREAU OF LAND & WATER RESOURCES  
 JUL - 1 1982  
 RECEIVED

If well telescopes please sketch and show depths.

GROUND LEVEL

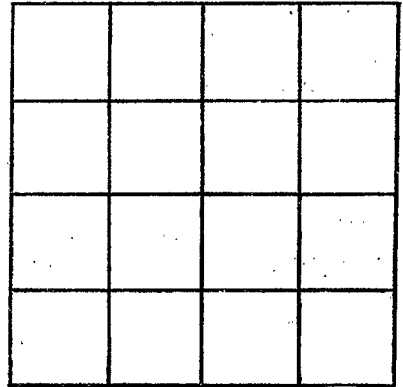

SECTION \_\_\_\_\_

Please indicate well location X.

ADDITIONAL INFORMATION

If more than one screen, show locations of each on sketch.