

MISSISSIPPI DEPARTMENT OF NATURAL RESOURCES

Bureau of Land and Water Resources

Southport Mall

P.O. Box 10631

Jackson, Mississippi 39209

WATER WELL DRILLERS LOG

Newton
F
2041

8-3-82
date well completed

McDonald's Well
firm name

Newton
county well located

LANDOWNER:	description of formations encountered	from	to
Ranahy M. Dill			
RT # 1 Decatur (mailing address)	shale	10	35
WELL LOCATION:	clay & sand	35	50
sec 20 T 7 N R 11 E 5 miles W of Decatur (distance) (direction) (nearest town)	sandy shale	50	90
WELL PURPOSE: none (home, irrigation, municipal, industrial)	shale & sand	90	180
WELL COMPLETION DATA:	sand	180	240
(1) diameter (inches) 4"	sandy shale	240	265
(2) total depth (feet) 310	shale	265	305
(3) static water level (feet) 190' below top of ground.	Rock & shell	305	330
(4) casing PVC 882 (material) (depth) 4" if telescope see back. (size)	green sand	330	340
(5) screen (length) (depth to top) (size) (material)	sand rock & shale	340	360
(6) pump 1 890m (HP) (y/d/gpm) F (type power)			
(7) electric log (yes or no) (organization running log)			
(8) how well bottom plugged open			

DEPT. OF NATURAL RESOURCES
BUREAU OF LAND & WATER RESOURCES


AUG - 9 1982

RECEIVED

DRILLERS REMARKS:

If well telescopes please sketch and show depths.

GROUND LEVEL

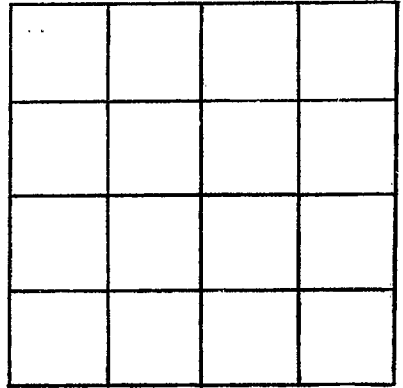

SECTION _____

Please indicate well location X.

ADDITIONAL INFORMATION

If more than one screen,
show locations of each on sketch.