

MISSISSIPPI DEPARTMENT OF NATURAL RESOURCES

Bureau of Land and Water Resources

Southport Mall

P.O. Box 10631

Jackson, Mississippi 39209

WATER WELL DRILLERS LOG

Newton
F
2042

10-19-82
 date well completed

McDonald & Hill
 firm name

Newton
 county well located

LANDOWNER:
Henry Lee Jones
RT #1 Decatur
 (mailing address)

WELL LOCATION:
 sec. 20 T 7 N R 11 E
4 miles W of Decatur
 (distance) (direction) (nearest town)

WELL PURPOSE: none
 (home, irrigation, municipal, industrial)

- WELL COMPLETION DATA:
- (1) diameter (inches) 4"
 - (2) total depth (feet) 360'
 - (3) static water level (feet) 150' below top of ground.
 - (4) casing PIPE 240'
 (material) (depth)
4"
 (size) if telescope see back.
 - (5) screen _____
 (length) (depth to top)
 (size) (material)
 - (6) pump 3 1/2 9 gpm
 (HP) (yield gpm)
F
 (type power)
 - (7) electric log _____
 (yes or no)
 (organization running log)
 - (8) how well bottom plugged open

description of formations encountered	from	to
clay & sand	0	12
sandy shale	12	40
shale	40	55
shale & sand	55	110
sand	140	190
sandy shale	190	225
shale	225	251
rock & shell	251	280
green sand & sandy shale	280	300
shale & rock & sand	300	360

DEPT. OF NATURAL RESOURCES
 BUREAU OF LAND & WATER RESOURCES


OCT 26 1982

RECEIVED

DRILLERS REMARKS:

If well telescopes please sketch and show depths.

GROUND LEVEL

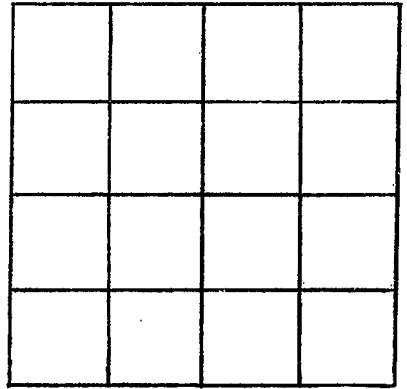

SECTION _____

Please indicate well location X.

ADDITIONAL INFORMATION

If more than one screen,
show locations of each on sketch.