

MISSISSIPPI DEPARTMENT OF NATURAL RESOURCES

Bureau of Land and Water Resources

Southport Mall

P.O. Box 10631

Jackson, Mississippi 39209

WATER WELL DRILLERS LOG

Newton
F
2043

12/18/82 19 Sony Drilling Co Newton
 date well completed firm name county well located

LANDOWNER:	description of formations encountered	from	to
Ralph Vaughan	yellow sand & clay	0	15
PT Lawrence, Miss	sand & clay	75	200
(mailing address)	clay	200	320
	sand & clay streaks	320	420

WELL LOCATION:
 sec. 19 T 7 N R 11 E
 S W
10-11 miles NW of Newton
 (distance) (direction) (nearest town)

WELL PURPOSE:
 (home, irrigation, municipal, industrial)

- WELL COMPLETION DATA:
- diameter (inches) 4
 - total depth (feet) 420
 - static water level (feet) 146 ^{below} top of ground.
 - casing PVC, 280,
 (material) (depth)
 _____ if telescope see back.
 (size)
 - screen _____,
 (length) (depth to top)
 _____,
 (size) (material)
 - pump 3/4 7
 (HP) (yield gpm)
Sub
 (type power)
 - electric log _____
 (yes or no)

 (organization running log)
 - how well bottom plugged open


DRILLERS REMARKS:

DEPT. OF NATURAL RESOURCES
 BUREAU OF LAND & WATER RESOURCES

AUG 13 1984
 RECEIVED

If well telescopes please sketch and show depths.

GROUND LEVEL

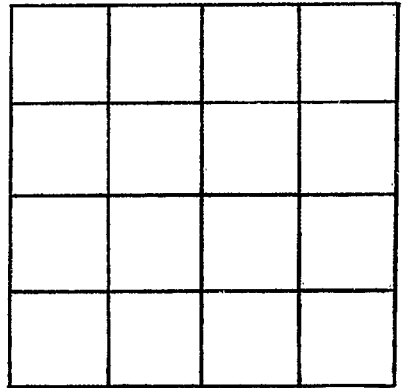

SECTION _____

Please indicate well location X.

ADDITIONAL INFORMATION

If more than one screen,
show locations of each on sketch.