

Newton  
F  
2044

MISSISSIPPI DEPARTMENT OF NATURAL RESOURCES  
 Bureau of Land and Water Resources  
 Southport Mall  
 P.O. Box 10631  
 Jackson, Mississippi 39209  
 WATER WELL DRILLERS LOG

1-12-83 19 McDonalds Well Newton  
 date well completed firm name county well located

LANDOWNER: Stepher Thomas  
Decatur  
 (mailing address)

WELL LOCATION:  
 sec. 13 T 7 N R. 11 E  
3 miles W of Decatur  
 (distance) (direction) (nearest town)

WELL PURPOSE:  
 (home, irrigation, municipal, industrial)

- WELL COMPLETION DATA:
- (1) diameter (inches) 4"
- (2) total depth (feet) 300'
- (3) static water level (feet) 140 below above top of ground.
- (4) casing PVC, 930'  
 (material) (depth)  
4" if telescope see back.  
 (size)
- (5) screen \_\_\_\_\_  
 (length) (depth to top)  
 (size) (material)
- (6) pump 3/4 800m  
 (HP) (field gpm)  
F  
 (type power)
- (7) electric log \_\_\_\_\_  
 (yes or no)  
 (organization running log)
- (8) how well bottom plugged open


description of formations encountered	from	to
<u>clay &amp; sand</u>	<u>0</u>	<u>25</u>
<u>sandy shale</u>	<u>25</u>	<u>70</u>
<u>shale</u>	<u>70</u>	<u>120</u>
<u>sand</u>	<u>120</u>	<u>200</u>
<u>sandy shale</u>	<u>200</u>	<u>220</u>
<u>shale</u>	<u>220</u>	<u>254</u>
<u>rock &amp; shells</u>	<u>254</u>	<u>275</u>
<u>green sand &amp; sandstone shale</u>	<u>275</u>	<u>300</u>

MISSISSIPPI DEPARTMENT OF NATURAL RESOURCES  
 BUREAU OF LAND & WATER RESOURCES  
 RECEIVED  
 JAN 17 1983

DRILLERS REMARKS:  
 \_\_\_\_\_  
 \_\_\_\_\_  
 \_\_\_\_\_

If well telescopes please sketch and show depths.

GROUND LEVEL

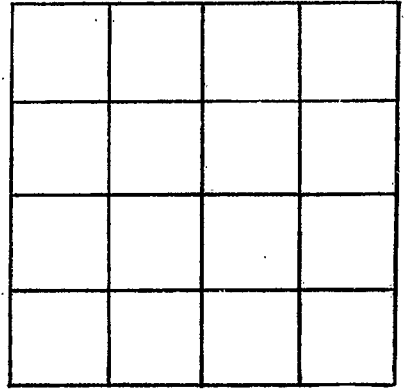

SECTION \_\_\_\_\_

Please indicate well location X.

ADDITIONAL INFORMATION

If more than one screen,  
show locations of each on sketch.