

Newton
F
2045

MISSISSIPPI DEPARTMENT OF NATURAL RESOURCES
Bureau of Land and Water Resources
Southport Mall
P.O. Box 10631
Jackson, Mississippi 39209
WATER WELL DRILLERS LOG

6-7-83 19 McDonald Hill NEWTON
date well completed firm name county well located

LANDOWNER:
G D HARRISON
Rt 1 DECATOR
(mailing address)

description of formations encountered	from	to
PLAY	0	8
PLAY SAND	8	25
CLAY	25	30
SAND ST SHALE	30	85
SOFT SHALE	85	110
SHALE	110	132
ROCK	132	135
ROCK ST SAND	135	152
SAND	152	180

WELL LOCATION:
sec. 14 T 9 R 11 W
2 miles WEST of DECATOR
(distance) (direction) (nearest town)

WELL PURPOSE: HOME
(home, irrigation, municipal, industrial)

- WELL COMPLETION DATA:
- (1) diameter (inches) 4"
 - (2) total depth (feet) 180'
 - (3) static water level (feet) 68 below top of ground.
 - (4) casing PVC, 118' (material) (depth)
(size) if telescope see back.
 - (5) screen 0 (length) (depth to top)
(size) (material)
 - (6) pump 1/2 (HP) 7 (yield gpm)
(type power)
 - (7) electric log (yes or no)
(organization running log)
 - (8) how well bottom plugged OPEN

DEPT. OF NATURAL RESOURCES
BUREAU OF LAND & WATER RESOURCES


JUN 13 1983

RECEIVED

DRILLERS REMARKS:

If well telescopes please
sketch and show depths.

GROUND LEVEL

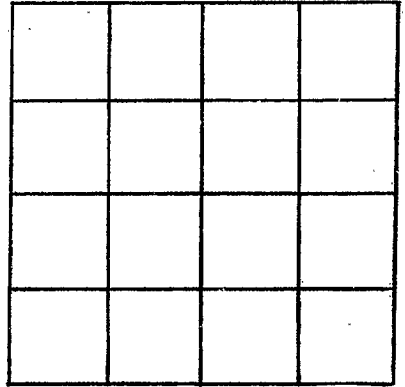

SECTION _____

Please indicate well location X.

ADDITIONAL INFORMATION

If more than one screen,
show locations of each on sketch.