

MISSISSIPPI DEPARTMENT OF NATURAL RESOURCES

Bureau of Land and Water Resources

Southport Mall

P.O. Box 10631

Jackson, Mississippi 39209

WATER WELL DRILLERS LOG

<u>Newton</u>
<u>F</u>
<u>2047</u>

10-8-83 19 McDonald + Hill

Newton

Newton

date well completed

firm name

county well located

LANDOWNER:	description of formations encountered	from	to
<u>Melvin Hollinsworth</u>	<u>Clay + sand</u>	<u>0</u>	<u>20</u>
<u>Rt #1 Decatur</u> (mailing address)	<u>sand + clay</u>	<u>20</u>	<u>85</u>
WELL LOCATION: sec <u>21</u> T <u>7</u> N R <u>11</u> E <u>6</u> miles <u>W</u> of <u>Decatur</u> (distance) (direction) (nearest town)	<u>shale</u>	<u>85</u>	<u>95</u>
WELL PURPOSE: <u>home</u> (home, irrigation, municipal, industrial)	<u>sandy shale</u>	<u>95</u>	<u>180</u>
WELL COMPLETION DATA: (1) diameter (inches) <u>4"</u>	<u>shale + sand + cligast</u>	<u>180</u>	<u>245</u>
(2) total depth (feet) <u>460</u>	<u>sand</u>	<u>245</u>	<u>330</u>
(3) static water level (feet) <u>300</u> below top of ground.	<u>sandy shale</u>	<u>330</u>	<u>365</u>
(4) casing <u>PVC</u> <u>380</u> (material) (depth)	<u>shale</u>	<u>365</u>	<u>398</u>
<u>4</u> if telescope see back. (size)	<u>Rock & shells</u>	<u>398</u>	<u>425</u>
(5) screen _____ (length) (depth to top)	<u>green sand & sandy shale</u>	<u>425</u>	<u>440</u>
(size) (material)	<u>st sand Rock & shells</u>	<u>440</u>	<u>460</u>
(6) pump <u>1</u> <u>8000</u> (HP) (yield gpm)			
<u>F</u> (type power)			
(7) electric log _____ (yes or no)			
(organization running log)			
(8) how well bottom plugged <u>Open</u>			

DEPT. OF NATURAL RESOURCES
BUREAU OF LAND & WATER RESOURCES


OCT 17 1993

RECEIVED

DRILLERS REMARKS:

If well telescopes please sketch and show depths.

GROUND LEVEL

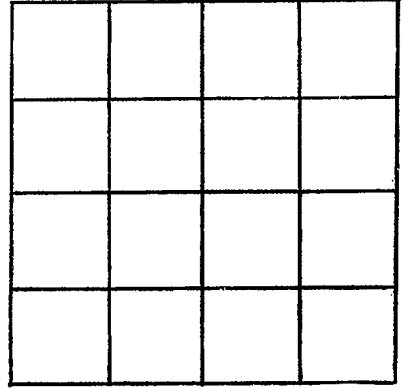

SECTION _____

Please indicate well location X.

ADDITIONAL INFORMATION

If more than one screen,
show locations of each on sketch.