

Newton
F
2048

MISSISSIPPI DEPARTMENT OF NATURAL RESOURCES
Bureau of Land and Water Resources
Southport Mall
P.O. Box 10631
Jackson, Mississippi 39209
WATER WELL DRILLERS LOG

3-28-84 19
date well completed

McDonald & Hill
firm name


Newton
county well located

LANDOWNER:	description of formations encountered	from	to
James Moore Rt #1 Decatur (mailing address)			
WELL LOCATION:	sandy shale at Rock	25	70
sec. <u>26</u> T <u>7</u> N R <u>11</u> E S W	shale	70	120
<u>2</u> miles <u>W</u> of <u>Decatur</u> (distance) (direction) (nearest town)	sandy shale	120	150
WELL PURPOSE: <u>home</u> (home, irrigation, municipal, industrial)	sand	150	190
WELL COMPLETION DATA:	sand shale	190	220
(1) diameter (inches) <u>4"</u>	shale	220	250
(2) total depth (feet) <u>300</u>	Rock & shells	250	270
(3) static water level (feet) <u>180</u> below top of ground.	green sand & sandy shale	270	290
(4) casing <u>PVC 200</u> (material) (depth)	shale	290	300
<u>4"</u> (size) if telescope see back.			
(5) screen _____ (length) (depth to top)			
(size) (material)			
(6) pump <u>34</u> <u>500m</u> (HP) (yeld'gpm)			
(type power)			
(7) electric log _____ (yes or no)			
(organization running log)			
(8) how well bottom plugged <u>open</u>			
DRILLERS REMARKS:			

DEPT. OF NATURAL RESOURCES
BUREAU OF LAND & WATER RESOURCES
APR - 2 1984
RECEIVED

If well telescopes please sketch and show depths.

GROUND LEVEL

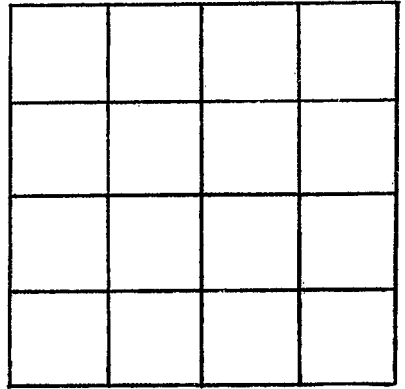

SECTION _____

Please indicate well location X.

ADDITIONAL INFORMATION

If more than one screen, show locations of each on sketch.