

MISSISSIPPI DEPARTMENT OF NATURAL RESOURCES

Bureau of Land and Water Resources

Southport Mall

P.O. Box 10631

Jackson, Mississippi 39209

WATER WELL DRILLERS LOG

Newton
R
2050

8-13-84

date well completed

McDonald & Hill

firm name

Newton

county well located

LANDOWNER:	description of formations encountered	from	to
Ed Holmes	clay & sand	0	50
Rt # Decatur (mailing address)	sand & shale	50	110
WELL LOCATION:	sand	110	145
sec. <u>9</u> T. <u>7</u> N. R. <u>11</u> E S W	sandy shale	145	185
<u>6</u> miles <u>W</u> of <u>Decatur</u> (distance) (direction) (nearest town)	shale	185	215
WELL PURPOSE: <u>home</u> (home, irrigation, municipal, industrial)	rocks & shells	215	230
WELL COMPLETION DATA:	open sand & sandy shale	230	245
(1) diameter (inches) <u>4"</u>	shale rocks & sand	245	260
(2) total depth (feet) <u>210'</u>			
(3) static water level (feet) <u>105'</u> below top of ground.			
(4) casing <u>PVC</u> , <u>200'</u> (material) (depth) <u>4"</u> (size) if telescope see back.			
(5) screen (length) (depth to top) (size) (material)			
(6) pump <u>3/4</u> <u>80 gpm</u> (HP) (yield gpm) <u>F</u> (type power)			
(7) electric log (yes or no) (organization running log)			
(8) how well bottom plugged <u>open</u>			

DEPT. OF NATURAL RESOURCES
BUREAU OF LAND & WATER RESOURCES


AUG 20 1984

DRILLERS REMARKS:

RECEIVED

If well telescopes please sketch and show depths.

GROUND LEVEL

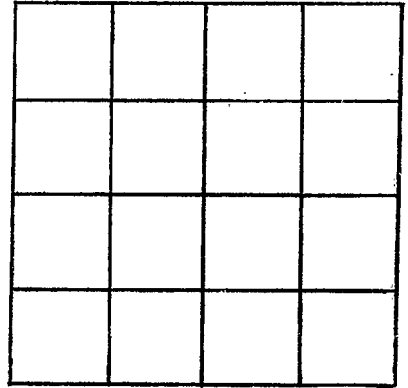

SECTION _____

Please indicate well location X.

ADDITIONAL INFORMATION

If more than one screen,
show locations of each on sketch.