

G 301

WATER WELL DRILLERS LOG

G5

7-20-60

Date: 7-20, 1960, Driller: W. L. Walden county Newton

(Name)

(1) Owner of Land: J. B. Smith
 (Name)
Decatur Miss.
 (Address)

(2) Location: NW 1/4, SW 1/4, Sec. 17 T. 7 R. 12
1 miles N. E. of Decatur
 (distance) (direction) (Nearest Town)

(3) Topography: (Hilly) (Flat) (Level)

(4) Purpose of Well: Domestic
 (Domestic Irrigation
 Municipal, Industrial, Other)

Description & Color of Materials Sand, Clay, Red Clay, Shell, etc.	Thick- ness Feet	Depth Feet
<u>Clay</u>	<u>10</u>	<u>0-10</u>
<u>Sand</u>	<u>20</u>	<u>10-30</u>
<u>Blue + Rocky</u>	<u>23</u>	<u>25-48</u>
<u>Shell</u>	<u>33</u>	<u>42-76</u>
<u>Sand</u>	<u>17</u>	<u>76-93</u>

Information upon completion of well:

(1) Diameter: 2" inches.

(2) Total Depth: 93' feet.

(3) Water Level: Flowing feet below top of ground.

(4) Cased to: 21', Size 2"


(5) Screen: Size None, Length _____

(6) Were any formations sealed against pollution?
 _____ yes, no.

If YES depth of formation _____

Why _____

Drillers Remarks: This was a Artesian Flowing well for Home.

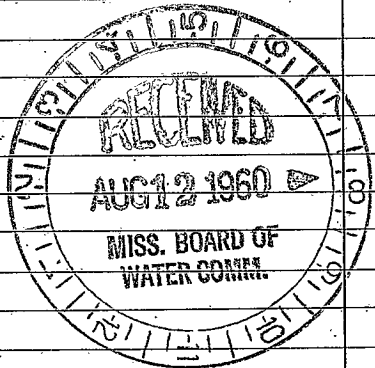

(Use Back Side)

