

G 300

WATER WELL DRILLERS LOG

(1) Owner of Land: Ray Knowlan
 (Name)
Deester Swiss
 (Address)

(2) Location: N 1/4, NW 1/4, Sec 33 T7R12E
3 miles S. E. of Deester
 (distance) (direction) (Nearest Town)

(3) Topography: (Hilly) (Flat) (Level)

(4) Purpose of Well: Domestic
 (Domestic Irrigation, Municipal, Industrial, Other)

Description & Color of Materials Sand, Clay, Red Clay, Shell, etc.	Thick- ness Feet	Depth Feet
Clay	54	0-54
Sandy	33	54-87
Blue + Rocky Shell	21	87-108
Sand	31	108-140
	10	140-150

Information upon completion of well:

(1) Diameter 2 inches.

(2) Total Depth 150' feet.

(3) Water Level 56 feet below top of ground.

(4) Cased to 105, Size 2"


(5) Screen: Size None, Length _____

(6) Were any formations sealed against pollution?
 _____ yes, no.

If YES depth of formation _____

Why _____

Drillers Remarks: _____

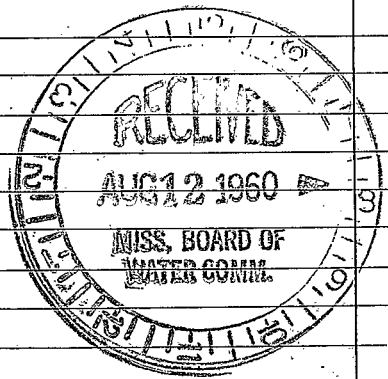

2

(Use Back Side)

Well No.

