

WATER WELL DRILLERS LOG

Newton

G 9
5-13-61

Date: 5/13, 1961, Driller: Hester Oglatree, County ~~Madison~~ Newton
(Name)

(1) Owner of Land: <u>M. V. Harris</u> (Name)	Description & Color of Materials Sand, Clay, Red Clay, Shell, etc.	Thick- ness Feet	Depth Feet
<u>Rt. 2 Decatur, Miss</u> (Address)	<u>37 ft. clay & sand</u>		
(2) Location: <u>1/4, 1/4, Sec. 10 T¹¹ R¹²</u>	<u>43 ft. Blue dirt & rock</u>		
<u>4 miles East</u> , of <u>Decatur</u> (distance) (direction) (Nearest Town)	<u>20 ft. water sand</u>		
(3) Topography: <u>Hilly</u> (Hilly) (Flat) (Level)			
(4) Purpose of Well: <u>Home use</u> (Domestic Irrigation Municipal, Industrial, Other)			


Information upon completion of well:

- (1) Diameter 4 1/4 inches.
- (2) Total Depth 99 feet.
- (3) Water Level 70 feet below top of ground.
- (4) Cased to 93, Size 2 in.
- (5) Screen: Size 1 1/4, Length 6 ft.
- (6) Were any formations sealed against pollution?
_____ yes, _____ no.

If YES depth of formation _____

Why _____

Drillers Remarks: _____

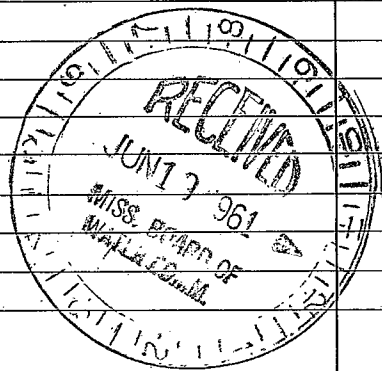

(Use Back Side)

Well No.

