

G14  
3-9-62

WATER WELL DRILLERS LOG

Date: 3-9, 1962, Driller: W. L. Helder County Newton  
(Name)

(1) Owner of Land: Marie Briffin  
(Name)  
Deater, Miss  
(Address)

(2) Location: NW 1/4, NW 1/4, Sec. 31 T. 2 R. 12  
2 miles South of Deater  
(distance) (direction) (Nearest Town)

(3) Topography: L  
(Hilly) (Flat) (Level)

(4) Purpose of Well: Domestic  
(Domestic Irrigation  
Municipal, Industrial, Other)

Description & Color of Materials Sand, Clay, Red Clay, Shell, etc.	Thick- ness Feet	Depth Feet
Red clay	32	0-32
Blue & shell	33	32-65
Gray + Sandy	22	65-87
Sandy	10	87-97
Sand	38	97-135

Information upon completion of well:

(1) Diameter 3 1/2 inches.

(2) Total Depth 135 feet.

(3) Water Level 85 feet below top of ground.


(4) Cased to 135, Size 2"

(5) Screen: Size 8 slot, Length 6'

(6) Were any formations sealed against pollution?  
\_\_\_\_\_ yes, \_\_\_\_\_ no.

If YES depth of formation \_\_\_\_\_  
Why \_\_\_\_\_

Drillers Remarks: \_\_\_\_\_

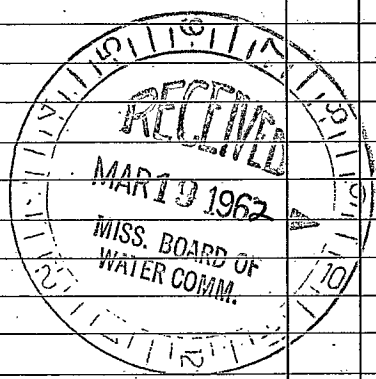

7

(Use Back Side)

31

Well No.

1  
2  
3  
100