

G15  
3-29-62

WATER WELL DRILLERS LOG

Date: 3-29, 1962 Driller: J. D. Shalh County Newton  
(Name)

(1) Owner of Land W. Ray Smith  
(Name)  
Reister Miss  
(Address)

(2) Location: 1/4, 1/4, Sec. 8 T 7R12  
2 miles E of Reister  
(distance) (direction) (Nearest Town)

(3) Topography: ✓  
(Hilly) (Flat) (Level)

(4) Purpose of Well: Domestic  
(Domestic Irrigation  
Municipal, Industrial, Other)

Description & Color of Materials Sand, Clay, Red Clay, Shell, etc.	Thick- ness Feet	Depth Feet
<u>S. clay</u>	<u>18</u>	<u>0-18</u>
<u>Blue</u>	<u>30</u>	<u>18-48</u>
<u>Shells</u>	<u>17</u>	<u>48-65</u>
<u>Sand</u>	<u>22</u>	<u>65-87</u>

Information upon completion of well:

(1) Diameter 3 1/2 inches.

(2) Total Depth 87 feet.

(3) Water Level 38 feet below top of ground.


(4) Cased to 53, Size 2"

(5) Screen: Size None, Length \_\_\_\_\_.

(6) Were any formations sealed against pollution?  
\_\_\_\_\_ yes, \_\_\_\_\_ no.

If YES depth of formation \_\_\_\_\_  
Why \_\_\_\_\_

Drillers Remarks: \_\_\_\_\_  
\_\_\_\_\_  
\_\_\_\_\_

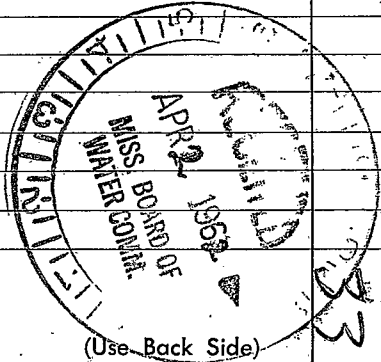

(Use Back Side)

Well No. 103

1948

1949

1950

1969