

3 NEWTON
G17

P

9-24-62

WATER WELL DRILLERS LOG

Date: 9-24, 1962, Driller: W. L. Welch County: Decatur
(Name)

(1) Owner of Land: E. C. Taylor
(Name)
Decatur Miss
(Address)

(2) Location: NE 1/4, NE 1/4, Sec 31 T 7 R 12
3 miles West, of Decatur,
(distance) (direction) (Nearest Town)

(3) Topography: (Hilly) (Flat) (Level)

(4) Purpose of Well: Domestic
(Domestic Irrigation, Municipal, Industrial, Other)


Description & Color of Materials Sand, Clay, Red Clay, Shell, etc.	Thick- ness Feet	Depth Feet
Red clay	12	0-12
Sand	53	12-64
Blue clay	10	64-74
Gravel	11	74-85

Information upon completion of well:

- (1) Diameter 2" inches.
- (2) Total Depth 85 feet.
- (3) Water Level 48 feet below top of ground.
- (4) Cased to 85, Size 2"
- (5) Screen: Size 8 slot Length 6"
- (6) Were any formations sealed against pollution?
_____ yes, no.

If YES depth of formation _____
Why _____

Drillers Remarks: _____

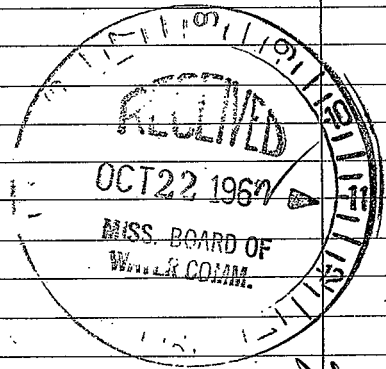

(Use Back Side)

Handwritten initials/signature

Well No.

