

6 G18

WATER WELL DRILLERS LOG

11-3-62

Date: 11-3, 1962, Driller: LEACH County: NEWTON

(Name)

(1) Owner of Land: JAMES BLACKBURN (Name)

Description & Color of Materials Sand, Clay, Red Clay, Shell, etc.

Thick-ness Feet

Depth Feet

DECATUR MISS (Address)

RED CLAY SAND

20 50

(2) Location: 1/4, 1/4, Sec. 10 T14N R12E

YELLOW CLAY BLUE CLAY

30 80 40 120

3 miles E, of DECATUR (distance) (direction) (Nearest Town)

BROWN SAND

75 195

(3) Topography: HILLY (Hilly) (Flat) (Level)

(4) Purpose of Well: DOMESTIC (Domestic Irrigation Municipal, Industrial, Other)


Information upon completion of well:

- (1) Diameter 2" inches.
(2) Total Depth 195 feet.
(3) Water Level 150 feet below top of ground.
(4) Cased to 195, Size 2"
(5) Screen: Size 2", Length 6'
(6) Were any formations sealed against pollution? yes, NO no.

If YES depth of formation

Why

Drillers Remarks:

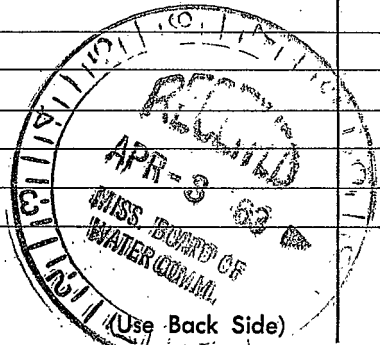

Well No.

100

101

102

200