

G19

WATER WELL DRILLERS LOG

5-15-63

Date: 5-15, 1963, Driller: W. L. Shelton

(Name)

(1) Owner of Land: R. Taylor
 (Name)
Decatur Miss
 (Address)

(2) Location: NE 1/4, NE 1/4, Sec. 6 T12
3 miles N, of Decatur
 (distance) (direction) (Nearest Town)

(3) Topography: (Hilly) (Flat) (Level)

(4) Purpose of Well: Domestic
 (Domestic Irrigation, Municipal, Industrial, Other)

Description & Color of Materials Sand, Clay, Red Clay, Shell, etc.	Thick- ness Feet	Depth Feet
Clay	40	0-10
Sand	48	

Information upon completion of well:

(1) Diameter 2 inches.

(2) Total Depth 58 feet.

(3) Water Level 36 feet below top of ground.

(4) Cased to 58, Size 24.


(5) Screen: Size 8 slot, Length 6'.

(6) Were any formations sealed against pollution?
 _____ yes, no.

If YES depth of formation _____

Why _____

Drillers Remarks: _____

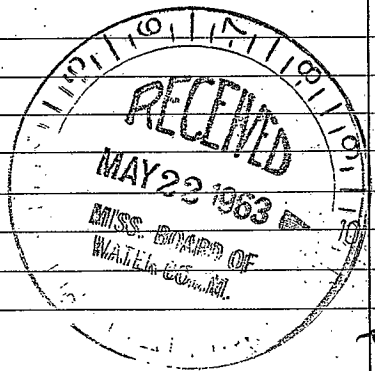

(Use Back Side)

Well No

1950

1951

1952

1978