

6 NEWTON

620

MISSISSIPPI BOARD OF WATER COMMISSIONERS

3-11-65

WATER WELL DRILLERS LOG


Date: 3-11, 1965, Driller: LEACH County Newton  
(When well drilled) (Name) (Where well is located)

(1) Owner of Land: SA, Prewer  
(Name)  
Decatur Miss Rt 1  
(Address)  
(2) Location: 1/4, 1/4, Sec. 14 T 14 R  
4 miles East, of Decatur  
(distance) (direction) (Nearest Town)  
(3) Topography: [check] (Hilly) (Flat) (Level)  
(4) Purpose of Well: [check] (Domestic Irrigation) (Municipal, Industrial, Other)

Description & Color of Materials Sand, Clay, Red Clay, Shell, etc.	Thick- ness Feet	Depth Feet
Red clay	20	20
yellow clay	40	60
Sand & clay	50	110
Sand	41	151

Information upon completion of well:

(1) Diameter 2 inches.  
(2) Total Depth 151 feet.  
(3) Water Level 30 feet below top of ground.  
(4) Cased to 146, Size 2"  
(5) Screen: Size 2, Length 5  
(6) Were any formations sealed against pollution?  
yes, [check] no.

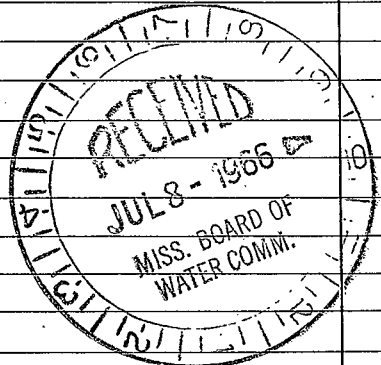

If YES depth of formation \_\_\_\_\_  
Why \_\_\_\_\_  
Drillers Remarks: \_\_\_\_\_  
Yield in gpm: 30  
Size pump: 1/2 HP  
Type power: \_\_\_\_\_

LE 151

