

NEWTON

G21 MISSISSIPPI BOARD OF WATER COMMISSIONERS

6-15-65

WATER WELL DRILLERS LOG


Date: 6-15, 1965, Driller: LEACH County Newton

(1) Owner of Land: H.M. Smith
Decatur miss
(2) Location: 1/4, 1/4, Sec. 14 T 7N R 12E
5 miles East of Decatur
(3) Topography: (Flat)
(4) Purpose of Well: Domestic

Table with 3 columns: Description & Color of Materials, Thickness Feet, Depth Feet. Rows include Sand, clay, Red shell, Blue clay, Shell & sand, Sand.

Information upon completion of well:

(1) Diameter 4 1/2 inches.
(2) Total Depth 245 feet.
(3) Water Level 65 feet below top of ground.
(4) Cased to 134, Size 4 1/2
(5) Screen: Size 10 1/2 Length 10
(6) Were any formations sealed against pollution? no.

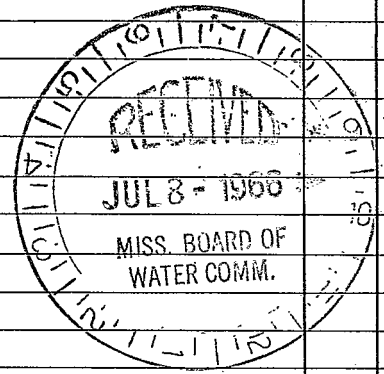

If YES depth of formation
Why
Drillers Remarks: Two wells 10' apart
Yield in gpm: 30
Size pump: 1 1/2 Hp 5 wd.
Type power:

