

6 NEWTON

G25

MISSISSIPPI BOARD OF WATER COMMISSIONERS

4-8-66

WATER WELL DRILLERS LOG

Date: 4-8, 1966, Driller: LEACH County Newton
 (When well drilled) (Name) (Where well is located)

(1) Owner of Land: Jimmy E Zell
 (Name)
Decatur Miss
 (Address)

(2) Location: 1/4, 1/4, Sec. 16 7N 12E
2 miles East, of Decatur
 (distance) (direction) (Nearest Town)

(3) Topography: (Hilly) (Flat) (Level)

(4) Purpose of Well:
 (Domestic, Irrigation, Municipal, Industrial, Other)

Description & Color of Materials Sand, Clay, Red Clay, Shell, etc.	Thick- ness Feet	Depth Feet
<u>Sand</u>	<u>20</u>	<u>20</u>
<u>Clay & Sand</u>	<u>30</u>	<u>70</u>
<u>Sand</u>	<u>50</u>	<u>120</u>

Information upon completion of well:

(1) Diameter 2 inches.


(2) Total Depth 120 feet.

(3) Water Level 18 feet below top of ground.

(4) Cased to 115, Size 2"

(5) Screen: Size 2", Length 2'

(6) Were any formations sealed against pollution?
 _____ yes, no.

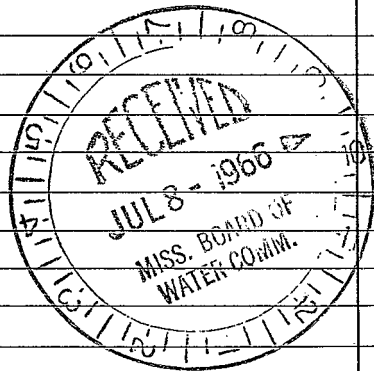

If YES depth of formation _____

Why _____

Drillers Remarks: _____

Yield in gpm: 20

Size pump: 1/2 HP

Type power: _____

Total 120

375
1000

Jan 18

1885

1000

Received of the
Hon. Secy of the
Interior
for the
land

1000

1000

