

312 G27

9

NEWTON
G27
8-67

MISSISSIPPI
BOARD OF WATER COMMISSIONERS
416 North State Street
Jackson, Mississippi 39201

WATER WELL DRILLERS LOG

8.21.67 date well completed McDonald-Bill firm name NEWTON county well located

LANDOWNER: C.L. GRAHAM

R#3 DECATUR

(mailing address)

WELL LOCATION:

sec. 14 T 7 N R 12 E
S W
7 miles EAST of DECATUR
(distance) (direction) (nearest town)


WELL PURPOSE: IRRIGATION
(home, irrigation, municipal, industrial)

WELL COMPLETION DATA:

- (1) diameter (inches) 4" WELL
- (2) total depth (feet) 248
- (3) static water level (feet) 120' below above top of ground.
- (4) casing BLACK, 88'
(material) (depth)
4"
(size) if telescope-see back.
- (5) screen NO, NO
(length) (depth to top)
NO, NO
(size) (material)
- (6) pump 3 HP, 5
(HP) (yield gpm)
220
(type power)
- (7) electric log NO
(yes or no)
NO
(organization running log)
- (8) how well bottom plugged OPEN


description of formations encountered	from	to
CLAY	0	30
SAND	30	65
SHALE	65	78
SAND	78	82
SHALE ST. ROCK	82	188
FINE SAND	188	248

DRILLERS REMARKS:

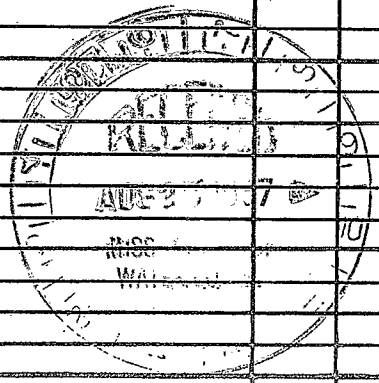

If well telescopes please sketch and show depths.

GROUND LEVEL

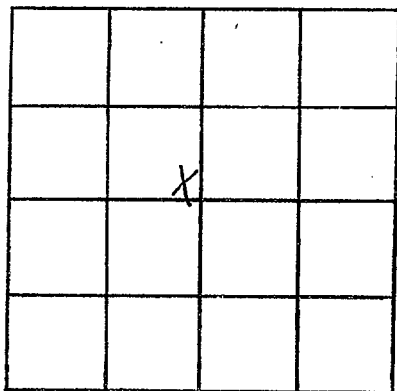

SECTION 14

Please indicate well location X.

ADDITIONAL INFORMATION

If more than one screen,
show locations of each on sketch.