

Newton
G29
7-68 CODED

MISSISSIPPI
BOARD OF WATER COMMISSIONERS
416 North State Street
Jackson, Mississippi 39201

WATER WELL DRILLERS LOG

July 15 1968 Ogletree Drilling Newton
date well completed firm name county well located

LANDOWNER:
E. L. Thorn

description of formations encountered	from	to
Red Clay	0	18
Red Sand	18	35
Blue Chalk	35	60
Blue Chalk & Rock	60	250

Decatur, Miss.
(mailing address)

WELL LOCATION:
sec 27 T 20 N R 12 E
S W
3 miles S.E. of Decatur
(distance) (direction) (nearest town)

WELL PURPOSE: ~~Domestic~~
(home, irrigation, municipal, industrial)

WELL COMPLETION DATA:

- (1) diameter (inches) 2"
- (2) total depth (feet) 295
- (3) static water level (feet) 25 ^{below} / _{above} top of ground.
- (4) casing Flow. 150
(material) (depth)
If telescope see back.
(size)
- (5) screen NONE
(length) (depth to top)
NONE
(size) (material)
- (6) pump 1 6.5
(HP) (yield gpm)
Elec.
(type power)
- (7) electric log _____
(yes or no)
(organization running log)
- (8) how well bottom plugged Open

CODED


AUG 13 1968

MISS. BD. OF
WATER COMMISSIONERS

DRILLERS REMARKS:

If well telescopes please sketch and show depths.

GROUND LEVEL

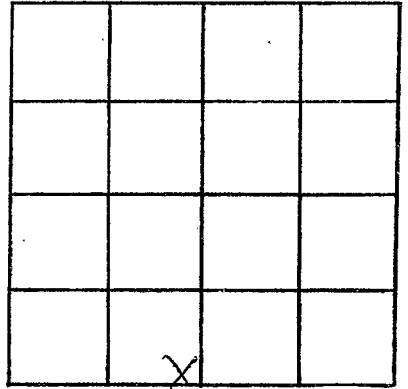

SECTION _____

Please indicate well location X.

ADDITIONAL INFORMATION

If more than one screen, show locations of each on sketch.