

Newton  
G 31  
6-26-69

MISSISSIPPI  
BOARD OF WATER COMMISSIONERS  
416 North State Street  
Jackson, Mississippi 39201

WATER WELL DRILLERS LOG

6-26 1969 RR Nicholson Newton  
date well completed firm name county well located

LANDOWNER: Mr E V Smith  
Decatur  
Miss  
(mailing address)


description of formations encountered	from	to
	<u>Clay &amp; Sand</u>	<u>0</u>
<u>Clay &amp; Sand</u>	<u>24</u>	<u>68</u>
<u>water Sand</u>	<u>68</u>	<u>72</u>

WELL LOCATION:  
sec. 17 T. 7 N R. 12 E  
3 1/2 miles East of Decatur  
(distance) (direction) (nearest town)

WELL PURPOSE: home  
(home, irrigation, municipal, industrial)


- WELL COMPLETION DATA:
- (1) diameter (inches) 4 1/4
  - (2) total depth (feet) 72
  - (3) static water level (feet) 49 below above top of ground.
  - (4) casing galv. pipe (material) 7 (depth)  
2" (size) if telescope see back.
  - (5) screen 5' (length) 72 (depth to top)  
1/4" (size) steel (material)
  - (6) pump 1/2 (HP) 7 (yield gpm)  
Elect (type power)
  - (7) electric log no (yes or no)
  - (8) how well bottom plugged joint

DRILLERS REMARKS:

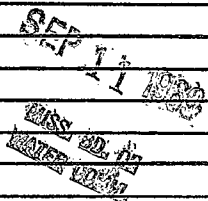

If well telescopes please sketch and show depths.

GROUND LEVEL

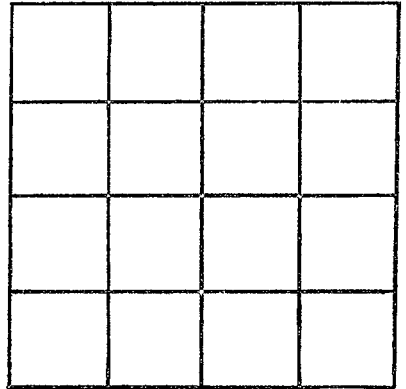

SECTION 12

Please indicate well location X.

ADDITIONAL INFORMATION

If more than one screen, show locations of each on sketch.