

Newton  
G32  
10-22-69

MISSISSIPPI  
 BOARD OF WATER COMMISSIONERS  
 416 North State Street  
 Jackson, Mississippi 39201

CODED

CODED

WATER WELL DRILLERS LOG

10-22 1969 BB Nicholson Newton  
 date well completed firm name county well located


LANDOWNER: <u>Virginia Williams</u>	description of formations encountered	from	to
<u>Union</u>	<u>blue dirt &amp; sand</u>	<u>0</u>	<u>45</u>
<u>Miss.</u>	<u>shell &amp; rock</u>	<u>45</u>	<u>90</u>
(mailing address)	<u>water sand</u>	<u>90</u>	<u>125</u>
WELL LOCATION:			
sec. <u>6</u> T. <u>T</u> N. R. <u>12</u> E. S. <u>W</u>			
<u>9</u> miles <u>SS</u> of <u>Union</u>			
(distance) (direction) (nearest town)			
WELL PURPOSE: <u>home</u>			
(home, irrigation, municipal, industrial)			
WELL COMPLETION DATA:			
(1) diameter (inches) <u>4 1/4</u>			
(2) total depth (feet) <u>125</u>			
(3) static water level (feet) <u>30</u> below top of ground.			
(4) casing <u>Galv. P.</u> <u>120</u>			
(material) (depth)			
<u>2"</u> if telescope see back.			
(size)			
(5) screen <u>5'</u> <u>125</u>			
(length) (depth to top)			
<u>1 1/4"</u> <u>Steel</u>			
(size) (material)			
(6) pump <u>1/2</u> <u>18</u>			
(HP) (yield gpm)			
<u>Elect</u>			
(type power)			
(7) electric log _____			
(yes or no)			
_____			
(organization running log)			
(8) how well bottom plugged _____			
DRILLERS REMARKS:			

JAN 21 1970

MISS. BD. OF  
 WATER COMM.

If well telescopes please sketch and show depths.

GROUND LEVEL

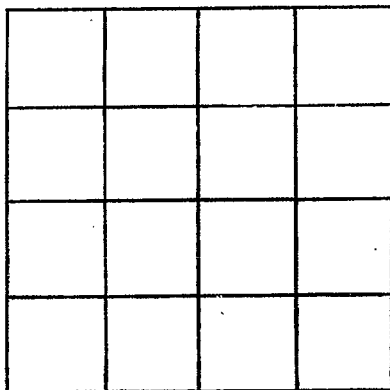

SECTION 6

Please indicate well location X.

ADDITIONAL INFORMATION

If more than one screen, show locations of each on sketch.