

Newton  
G 34  
6-2-70  
 300

MISSISSIPPI  
 BOARD OF WATER COMMISSIONERS  
 416 North State Street  
 Jackson, Mississippi 39201

WATER WELL DRILLERS LOG

6-2-70 date well completed      McDONALD HILL firm name      NEWTON county well located

LANDOWNER:  
TRAVIS Ludlow  
DECATUR  
 (mailing address)

description of formations encountered	from to	
	feet	feet
<u>Clay</u>	<u>0</u>	<u>18</u>
<u>Sandy Lt Clay</u>	<u>18</u>	<u>34</u>
<u>Shale</u>	<u>34</u>	<u>98</u>
<u>Sand</u>	<u>98</u>	<u>195</u>
<u>Soft Shale</u>	<u>195</u>	<u>220</u>
<u>Shale</u>	<u>220</u>	<u>260</u>
<u>Sand</u>	<u>260</u>	<u>280</u>

WELL LOCATION: 008  
 sec. 31 T. 7 N. R. 12 E  
2 miles SOUTH of DECATUR  
 (distance) (direction) (nearest town)

WELL PURPOSE: HOME  
 (home, irrigation, municipal, industrial)

- WELL COMPLETION DATA:
- (1) diameter (inches) 4"
  - (2) total depth (feet) 280'
  - (3) static water level (feet) 155 below top of ground.
  - (4) casing BLK 230'  
 (material) (depth)  
4" if telescope see back.  
 (size)
  - (5) screen \_\_\_\_\_  
 (length) (depth to top)  
 \_\_\_\_\_  
 (size) (material)
  - (6) pump 34 10  
 (HP) (yield gpm)  
220  
 (type power)
  - (7) electric log \_\_\_\_\_  
 (yes or no)  
 \_\_\_\_\_  
 (organization running log)
  - (8) how well bottom plugged OPEN


JUN 8 1970

MISS. BD. OF  
 WATER COMM.

DRILLERS REMARKS:  
 \_\_\_\_\_  
 \_\_\_\_\_

If well telescopes please sketch and show depths.

GROUND LEVEL

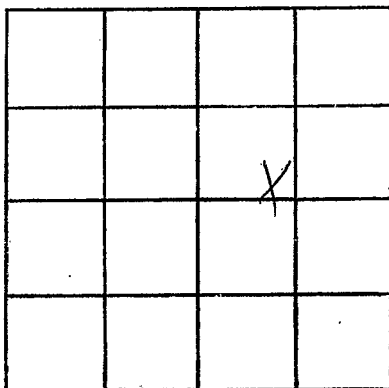

SECTION \_\_\_\_\_

Please indicate well location X.

ADDITIONAL INFORMATION

If more than one screen,  
show locations of each on sketch.