

NEWTON
G35
2-24-71

MISSISSIPPI
 BOARD OF WATER COMMISSIONERS
 416 North State Street
 Jackson, Mississippi 39201

CODED

WATER WELL DRILLERS LOG

2-24 1971 COMANS Drilling Newton
 date well completed firm name county well located

LANDOWNER: Billy Ray Smith

description of formations encountered

from

to

Signature R.H.

Clay 0 28

Miss

(mailing address)

SAND 28 47

WELL LOCATION:

Clay 47 58

sec. 4 T. 7 N. R. 12 E.

SAND 58 69

3 miles N-E of Doxalve
 (distance) (direction) (nearest town)

Clay 69 112

SAND 112 133

WELL PURPOSE:

Clay 133 168

(home, irrigation, municipal, industrial)

Rock + shell 168 204

WELL COMPLETION DATA:

SAND 204 225

- (1) diameter (inches) 2"
- (2) total depth (feet) 225
- (3) static water level (feet) _____ below above top of ground.

- (4) casing Steel, 189
 (material) (depth)
 (size) if telescope see back.

- (5) screen None
 (length) (depth to top)
 (size) (material)

- (6) pump 1" 5
 (HP) (yield gpm)
Electric
 (type power)

- (7) electric log No
 (yes or no)

(organization running log)

- (8) how well bottom plugged None

CODED

MAR 2 - 1971


MISS. RD. ON
 WATER BOARD

DRILLERS REMARKS: Open

Bottom

If well telescopes please sketch and show depths.

GROUND LEVEL

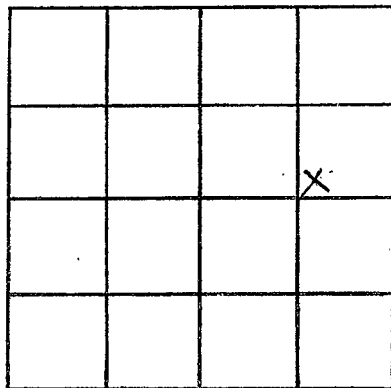

SECTION 4

Please indicate well location X.

ADDITIONAL INFORMATION

If more than one screen, show locations of each on sketch.