

Newton
G 39
12-29-72

MISSISSIPPI
BOARD OF WATER COMMISSIONERS
416 North State Street
Jackson, Mississippi 39201

CODED

WATER WELL DRILLERS LOG

12.29.72 date well completed
McDONALD + HILL firm name
NEWTON county well located

LANDOWNER:
Clyde LOPER
Rt 2 DECATUR
(mailing address)

description of formations encountered	from	to
Clay	0	12
SAND + CLAY	12	36
SANDy	36	45
SHALE	45	72
ROCK ST SAND	72	98
SAND + SHALE	98	130
SANDy	130	150

WELL LOCATION:
sec. 16 T 7 N R 12 E
S W
2 miles EAST of DECATUR
(distance) (direction) (nearest town)

WELL PURPOSE: FLORAS
(home, irrigation, municipal, industrial)

- WELL COMPLETION DATA:
- (1) diameter (inches) 4 7/8
 - (2) total depth (feet) 150'
 - (3) static water level (feet) 84' below above top of ground.
 - (4) casing PVC, 70'
(material) (depth)
4 7/8 if telescope see back.
(size)
 - (5) screen _____
(length) (depth to top)
(size) (material)
 - (6) pump 10 10
(HP) (yield gpm)
ELECTRIC
(type power)
 - (7) electric log NO
(yes or no)
NO
(organization running log)
 - (8) how well bottom plugged OPEN

CODED


JAN 2 1973

DRILLERS REMARKS:

MISSISSIPPI BOARD OF WATER COMMISSIONERS
416 NORTH STATE STREET
JACKSON, MISSISSIPPI 39201

If well telescopes please
sketch and show depths.

GROUND LEVEL

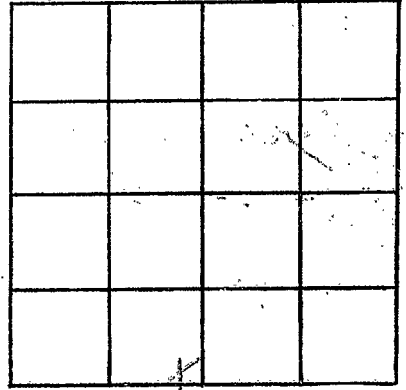

SECTION _____

Please indicate well location X.

ADDITIONAL INFORMATION

If more than one screen,
show locations of each on sketch.