

Newton  
G40  
3-31-73

MISSISSIPPI  
BOARD OF WATER COMMISSIONERS  
416 North State Street  
Jackson, Mississippi 39201

CODED

WATER WELL DRILLERS LOG

3-31-1973  
date well completed

Harold Poole  
Collinsville, Ms. 39325

Newton  
county well located

LANDOWNER: C. O. Smith  
Route #1 P.O.B. 344  
Decatur, Ms. 39827  
(mailing address)

description of formations encountered

from to

Top Surface  
Red Clay

0' 9'

Sand

9' 52'

WELL LOCATION:

sec. 21 T. 7 N R. 12 E  
2 miles East of Decatur  
(distance) (direction) (nearest town)

Light Gray Form  
CLAY

52' 62'

WELL PURPOSE: Home  
(home, irrigation, municipal, industrial)

White Coarse Sand Form

62' 82'

WELL COMPLETION DATA:

- (1) diameter (inches) 2"
- (2) total depth (feet) 82'
- (3) static water level (feet) 42' below  
top of ground.
- (4) casing Galv. 76'  
(material) (depth)  
(size) if telescope see back.
- (5) screen 6' 76'  
(length) (depth to top)  
1 1/4" Stainless  
(size) (material)
- (6) pump 1 3/4 (HP) 9  
(yield gpm)  
Electric  
(type power)
- (7) electric log (yes or no)  
(organization running log)
- (8) how well bottom plugged Back-  
Wash Valve


CODED

MAY 7 1973

DRILLERS REMARKS:

If well telescopes please sketch and show depths.

GROUND LEVEL

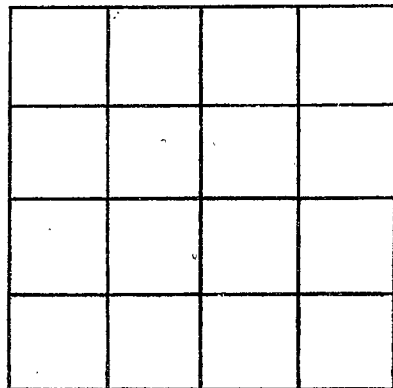

SECTION \_\_\_\_\_

Please indicate well location X.

ADDITIONAL INFORMATION

If more than one screen,  
show locations of each on sketch.