

NEWTON

6 41

7-24-73

MISSISSIPPI BOARD OF WATER COMMISSIONERS
416 North State Street
Jackson, Mississippi 39201

CODED

WATER WELL DRILLERS LOG

7. 24 - 73

MCDONALD + HILL

NEWTON

date well completed

firm name

county well located

LANDOWNER:

NEWTON CO ACADEMY

DECATUR MISS
(mailing address)

WELL LOCATION:

sec. 30 T. 7 N R. 12 E

1 miles SOUTH of DECATUR
(distance) (direction) (nearest town)

WELL PURPOSE: HOME
(home, irrigation, municipal, industrial)

WELL COMPLETION DATA:

- (1) diameter (inches) 4"
- (2) total depth (feet) 320
- (3) static water level (feet) 90' below top of ground.
- (4) casing PVC 125' (material) (depth)
4" (size) if telescope see back.
- (5) screen _____ (length) (depth to top)
(size) (material)
- (6) pump 1 Sub 15 (HP) (yield gpm)
220 (type power)
- (7) electric log _____ (yes or no)
(organization running log)
- (8) how well bottom plugged OPEN

description of formations encountered

from to

CLAY

0 18

SAND

18 35

SHALE

35 40

SAND

40 75

SOFT SANDY

75 95

SHALE

95 130

~~ROCK ST SHALE~~

130 137

SAND ST SHALE

137 150

ROCK ST SHALE

150 280

SHALE

280 300

SAND


300 320

MAR 26 1973

DRILLERS REMARKS:

If well telescopes please sketch and show depths.

GROUND LEVEL

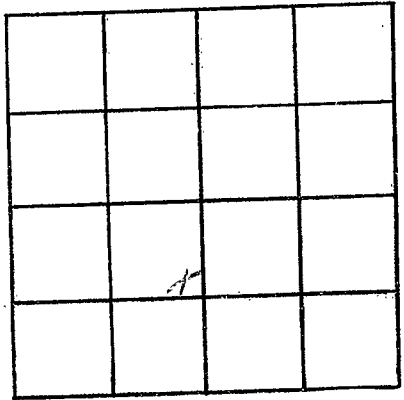

SECTION _____

Please indicate well location X.

ADDITIONAL INFORMATION

If more than one screen, show locations of each on sketch.