

G 42
 NEWTON
 8-13-73

MISSISSIPPI
 BOARD OF WATER COMMISSIONERS
 416 North State Street
 Jackson, Mississippi 39201

CODED

WATER WELL DRILLERS LOG

8, 13, 73 date well completed
 McDONALD + HILL firm name
 NEWTON county well located

LANDOWNER:	description of formations encountered	from	to
CECIL IVEY	Clay	0	18
R# 2 DECATUR (mailing address)	Sand to Clay	18	82
WELL LOCATION:	SHALE	82	112
sec <u>32</u> T <u>7</u> (N) R <u>12</u> (E) S W	ROCK	112	120
<u>2</u> miles S. EAST of DECATUR (distance) (direction) (nearest town)	ROCK ST SAND	120	130
WELL PURPOSE: <u>HOME</u> (home, irrigation, municipal, industrial)	SANDY	130	195

- WELL COMPLETION DATA:
- (1) diameter (inches) 4"
 - (2) total depth (feet) 195'
 - (3) static water level (feet) 104' below top of ground.
 - (4) casing DVE 108'
(material) (depth)
4" if telescope see back.
(size)
 - (5) screen _____
(length) (depth to top)
(size) (material)
 - (6) pump 1/2 6
(HP) (yield gpm)
ELECTRIC
(type power)
 - (7) electric log _____
(yes or no)
(organization running log)
 - (8) how well bottom plugged OPEN


DRILLERS REMARKS:

AUG 10 1973

SET PUMP 105

If well telescopes please sketch and show depths.

GROUND LEVEL

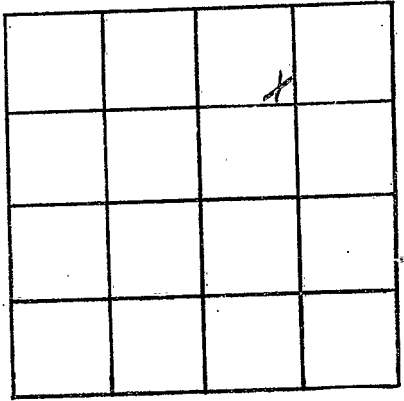

SECTION _____

Please indicate well location X.

ADDITIONAL INFORMATION

If more than one screen, show locations of each on sketch.