

G 43
 NEWTON
 8-14-73

MISSISSIPPI
 BOARD OF WATER COMMISSIONERS
 416 North State Street
 Jackson, Mississippi 39201

CODED

WATER WELL DRILLERS LOG

8.14.73 19 McDONALD + HILL NEWTON
 date well completed firm name county well located


LANDOWNER:	description of formations encountered	from	to
CHARLES BOSWELL	CLAY	0	18
R# 2 DECATUR (mailing address)	SHALE	18	40
WELL LOCATION: sec. 33 T 7 N R 12 E S W 3 miles SEAST DECATUR (distance) (direction) (nearest town)	SANDY SHALE	40	100
WELL PURPOSE: <u>LANE</u> (home, irrigation, municipal, industrial)	ROCK ST SHALE	100	92
WELL COMPLETION DATA:	SAND	120	140
(1) diameter (inches) <u>4 1/2</u>	SANDY	140	175
(2) total depth (feet) <u>175'</u>			
(3) static water level (feet) <u>46'</u> below top of ground.			
(4) casing <u>PVC 88'</u> (material) (depth) <u>4 1/2</u> if telescope see back. (size)			
(5) screen _____ (length) (depth to top) (size) (material)			
(6) pump <u>1/2 sub 10</u> (HP) (yield gpm) <u>ELECTRIC</u> (type power)			
(7) electric log _____ (yes or no) (organization running log)			
(8) how well bottom plugged <u>OPEN</u>			
DRILLERS REMARKS:			

AUG 18 1973

SET PUMP 85'

If well telescopes please sketch and show depths.

GROUND LEVEL

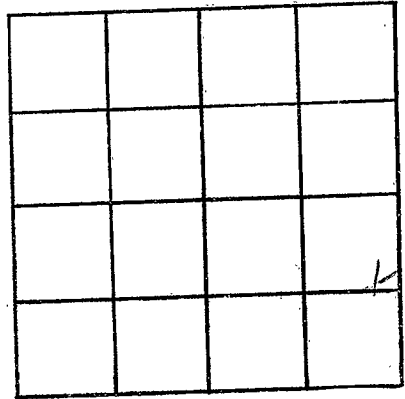

SECTION _____

Please indicate well location X.

ADDITIONAL INFORMATION

If more than one screen, show locations of each on sketch.