

NEWTON
G 44
8-20-73

MISSISSIPPI
BOARD OF WATER COMMISSIONERS
416 North State Street
Jackson, Mississippi 39201

CODED

WATER WELL DRILLERS LOG

8-20 1973 U. S. Welch Newton
date well completed firm name county well located

LANDOWNER: E. C. Huey

description of formations encountered

from to

Deater's Mine

Red clay

0 18

(mailing address)

Sandy

18 50

WELL LOCATION:

sec. 6-T-7-N R-13-E

2 miles N of Deater's
(distance) (direction) (nearest town)

Black

50 96

Gray of Rock

96 120

WELL PURPOSE: Home
(home, irrigation, municipal, industrial)

Sandy

120 140

sand

140 160

WELL COMPLETION DATA:

- (1) diameter (inches) 2"
(2) total depth (feet) 160
(3) static water level (feet) 64 below above top of ground.

(4) casing 2" Gal steel
(material) (depth)

(size) if telescope see back.

(5) screen Open Hole
(length) (depth to top)

(size) (material)

(6) pump (HP) (yield gpm)

(type power)

(7) electric log (yes or no)

(organization running log)

(8) how well bottom plugged

CODED

SEP 11 1973


MISS. Bd. OF WATER COMMISSIONERS

DRILLERS REMARKS: M. Huey

Was going to install pump

If well telescopes please sketch and show depths.

GROUND LEVEL

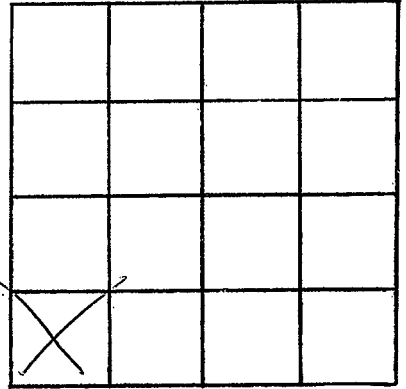

SECTION _____

Please indicate well location X.

ADDITIONAL INFORMATION

If more than one screen,
show locations of each on sketch.