

**NEWTON**  
**G 45**  
**9-27-73**

MISSISSIPPI  
 BOARD OF WATER COMMISSIONERS  
 416 North State Street  
 Jackson, Mississippi 39201

**CODED**

**WATER WELL DRILLERS LOG**

9.27.73  
 date well completed

McDONALD + Hill  
 firm name

NEWTON  
 county well located

LANDOWNER:  
 DR BOGAN  
 DECATUR  
 (mailing address)

WELL LOCATION:  
 sec. 20 T. 70 N. R. 12 E  
 1/2 miles EAST of DECATUR  
 (distance) (direction) (nearest town)

description of formations encountered.	from	to
CLAY	0	10
SAND	10	50
SAND	50	60
SHALE	60	84
ROCK SHALE	84	102
SAND ST ROCK	102	120
ROCK ST SHALE	120	240
SAND	240	260

WELL PURPOSE: HOME  
 (home, irrigation, municipal, industrial)

WELL COMPLETION DATA:

(1) diameter (inches) 4"

(2) total depth (feet) 260

(3) static water level (feet) 162' below above top of ground.

(4) casing: PVC 80' (material) (depth)  
 4" (size) if telescope see back.

(5) screen (length) (depth to top)  
 (size) (material)

(6) pump 1/2 sub 10 (HP) (yield gpm)  
 ELECTRIC (type power)

(7) electric log (yes or no)

(organization running log)

(8) how well bottom plugged OPEN


**CODED**

DRILLERS REMARKS:

OCT 01 1973

If well telescopes please sketch and show depths.

GROUND LEVEL

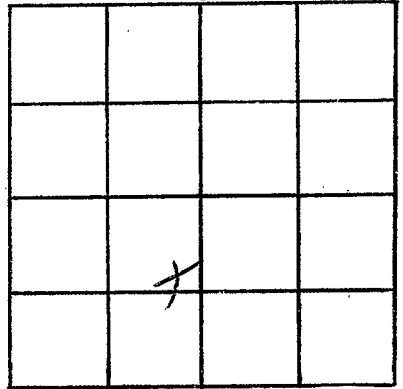

SECTION \_\_\_\_\_

Please indicate well location X.

ADDITIONAL INFORMATION

If more than one screen, show locations of each on sketch.