

NEWTON
G 46
12-17-73

MISSISSIPPI
 BOARD OF WATER COMMISSIONERS
 416 North State Street
 Jackson, Mississippi 39201

CODED

WATER WELL DRILLERS LOG

12-17-73 date well completed
 McDONALD HILL firm name
 NEWTON county well located

LANDOWNER:
 MICHAEL ADDY
 R#2 DECATUR
 (mailing address)

WELL LOCATION:
 sec. 5 T 7 N R 12 E
 S
 3 miles NORTH of DECATUR
 (distance) (direction) (nearest town)

WELL PURPOSE: FOUNTAIN
 (home, irrigation, municipal, industrial)

- WELL COMPLETION DATA:
- (1) diameter (inches) 4 1/2
 - (2) total depth (feet) 250
 - (3) static water level (feet) 105 below top of ground.
 - (4) casing PVC 106' (material) (depth)
 4" (size) if telescope see back.
 - (5) screen (length) (depth to top)
 (size) (material)
 - (6) pump 1/2 Sub 10 (HP) (yield gpm)
 ELECTRIC (type power)
 - (7) electric log (yes or no)
 (organization running log)
 - (8) how well bottom plugged OPEN

description of formations encountered	from	to
CLAY	0	18
SAND	18	58
CLAY ST SAND	58	78
SHALE	78	108
ROCK ST SHALE	108	125
SAND ST ROCK	125	140
SAND	140	150
ROCK ST SHALE	150	230
SAND	230	250


CODED

DEC 19 1973

DRILLERS REMARKS:
 SET PUMP 130'

If well telescopes please sketch and show depths.

GROUND LEVEL

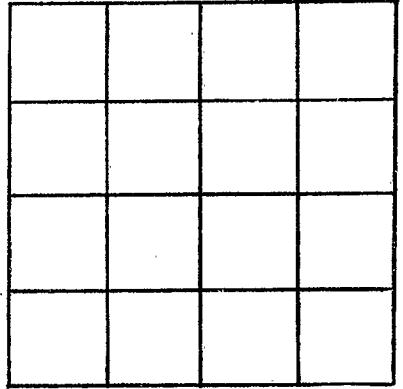

SECTION _____

Please indicate well location X.

ADDITIONAL INFORMATION

If more than one screen, show locations of each on sketch.