

**NEWTON**  
**G 47**  
**12-14-73**

MISSISSIPPI  
 BOARD OF WATER COMMISSIONERS  
 416 North State Street  
 Jackson, Mississippi 39201

**CODED**

**WATER WELL DRILLERS LOG**

12-14-73  
 date well completed

McDONALD + Hill  
 firm name

NEWTON  
 county well located

**LANDOWNER:**

C. D. LOPER

R#2 DECATUR  
 (mailing address)

**WELL LOCATION:**

sec. 15 T. 7 N R. 12 E  
 2 1/2 miles EAST of DECATUR  
 (distance) (direction) (nearest town)

**WELL PURPOSE:**

(home, irrigation, municipal, industrial)

**WELL COMPLETION DATA:**

- (1) diameter (inches) 4"
- (2) total depth (feet) 150
- (3) static water level (feet) 45' below above top of ground.
- (4) casing PVC, 90'  
 (material) (depth)  
4" if telescope see back.  
 (size)
- (5) screen \_\_\_\_\_  
 (length) (depth to top)  
 (size) (material)
- (6) pump 1/2 sub 12  
 (HP) (yield gpm)  
Eberrie  
 (type power)
- (7) electric log \_\_\_\_\_  
 (yes or no)  
 (organization running log)
- (8) how well bottom plugged OPEN

**description of formations encountered**

| from | to  |
|------|-----|
| 0    | 12  |
| 12   | 24  |
| 24   | 50  |
| 50   | 110 |
| 110  | 130 |
| 130  | 150 |

CLAY  
 SAND CLAY  
 SAND  
 SHALE ST ROCK  
 SAND ST SHALE  
 SAND


**CODED**

DRILLERS REMARKS:

DEC 19 1973

If well telescopes please sketch and show depths.

GROUND LEVEL

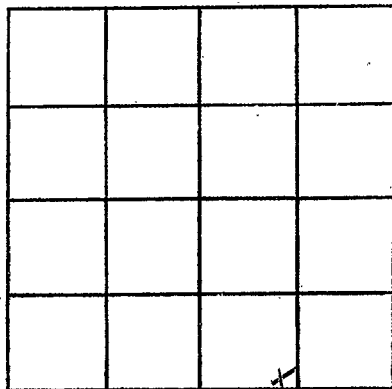

SECTION \_\_\_\_\_

Please indicate well location X.

ADDITIONAL INFORMATION

If more than one screen,  
show locations of each on sketch.