

NEWTON

G 49

6-21-74

MISSISSIPPI BOARD OF WATER COMMISSIONERS
416 North State Street
Jackson, Mississippi 39201

CODED

WATER WELL DRILLERS LOG

6-21 1974
date well completed

U. L. Melch Newton
firm name county well located

LANDOWNER: B Rignow

description of formations encountered from to

Dacatur
Miss (mailing address)

Red Clay 0 18

Black 18 20

WELL LOCATION:

sec. 18 T. 7 N. R. 12 E

Grey Rock 70 100

1/4 miles W of Dacatur (distance) (direction) (nearest town)

Grey Shell 100 120

WELL PURPOSE: Home (home, irrigation, municipal, industrial)

Sand 120 138

WELL COMPLETION DATA:

(1) diameter (inches) 3"

(2) total depth (feet) 138

(3) static water level (feet) 24 below top of ground.

(4) casing PVC (material) (depth) (size) If telescope see back.

(5) screen 10 (length) (depth to top)

3" PVC (size) (material)

(6) pump 1 (HP) 420 (yield gpm)

elec (type power)

(7) electric log (yes or no)

(organization running log)

(8) how well bottom plugged


CODED

RECEIVED
JUL 2 1974

DRILLERS REMARKS:

If well telescopes please sketch and show depths.

GROUND LEVEL

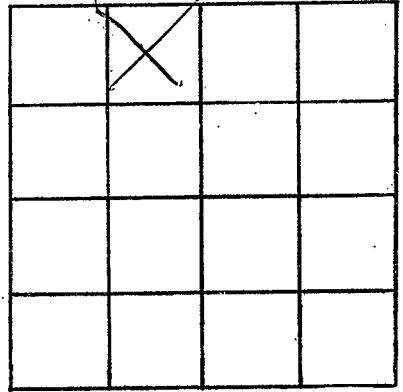

SECTION _____

Please indicate well location X.

ADDITIONAL INFORMATION

If more than one screen, show locations of each on sketch.