

NEWTON
G 51
9/19/74

MISSISSIPPI
 BOARD OF WATER COMMISSIONERS
 416 North State Street
 Jackson, Mississippi 39201 **CODED**

WATER WELL DRILLERS LOG

9-19
 date well completed

St. Comens Drilling
 firm name

Newton
 county well located

LANDOWNER: Larry Muse

Rt 2 Pecature

Muse

(mailing address)

WELL LOCATION:

sec. 26 T 9 N R. 12E
6 miles E of Pecature
 (distance) (direction) (nearest town)

WELL PURPOSE: Home
 (home, irrigation, municipal, industrial)

WELL COMPLETION DATA:

- (1) diameter (inches) 2"
- (2) total depth (feet) 320
- (3) static water level (feet) _____ below above top of ground.
- (4) casing Steel, 293,
 (material) (depth)
 _____ if telescope see back.
 (size)
- (5) screen More,
 (length) (depth to top)
 _____ (size) _____ (material)
- (6) pump 1 1/2 5
 (HP) (yield gpm)
F
 (type power)
- (7) electric log no
 (yes or no)
 _____ (organization running log)
- (8) how well bottom plugged _____

description of formations encountered

from

to

<u>Clay</u>	<u>0</u>	<u>60</u>
<u>Rock + Sand</u>	<u>60</u>	<u>100</u>
<u>Rock + Silt</u>	<u>100</u>	<u>140</u>
<u>Clay + Rock</u>	<u>140</u>	<u>190</u>
<u>Clay</u>	<u>190</u>	<u>205</u>
CODED		
<u>Sand Very Fine</u>	<u>205</u>	<u>255</u>
<u>Clay</u>	<u>255</u>	<u>280</u>
<u>Sand</u>	<u>280</u>	<u>320</u>


RECEIVED
NOV 20 1974

MISS. BLD. OF WATER COMMISSIONERS

DRILLERS REMARKS:

If well telescopes please sketch and show depths.

GROUND LEVEL

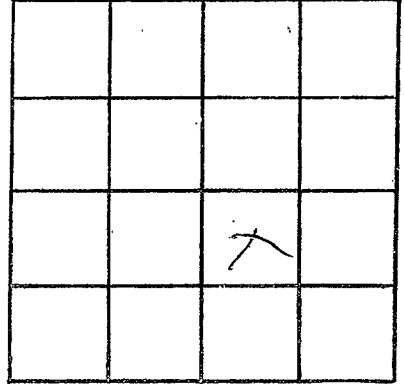

SECTION _____

Please indicate well location X.

ADDITIONAL INFORMATION

If more than one screen,
show locations of each on sketch.