

NEWTON
G 52
2-4-75

MISSISSIPPI
BOARD OF WATER COMMISSIONERS
 416 North State Street
 Jackson, Mississippi 39201

CODED

WATER WELL DRILLERS LOG

2. 4. 75 19 McDONALD HILL NEWTON
 date well completed firm name county well located

LANDOWNER:	description of formations encountered	from	to
<u>SELBY SAVELL</u>	<u>CLAY</u>	<u>0</u>	<u>12</u>
<u>DECATUR</u> (mailing address)	<u>SAND</u>	<u>12</u>	<u>95</u>
WELL LOCATION:	<u>SOFT SHALE</u>	<u>95</u>	<u>110</u>
sec. <u>16</u> T. <u>7</u> N. R. <u>10</u> E	<u>SHALE</u>	<u>110</u>	<u>138</u>
<u>2 1/2</u> miles <u>EAST</u> of <u>DECATUR</u> (distance) (direction) (nearest town)	<u>ROCK ST SAND</u>	<u>138</u>	<u>155</u>
WELL PURPOSE: <u>HOME</u> (home) irrigation, municipal, industrial)	<u>GREEN SAND</u>	<u>155</u>	<u>190</u>
	<u>ST ROCK</u>		
WELL COMPLETION DATA:			
(1) diameter (inches) <u>4 1/2</u>			
(2) total depth (feet) <u>190'</u>			
(3) static water level (feet) <u>10'</u> below top of ground.			
(4) casing <u>PVC</u> , <u>135'</u> (material) (depth)			
<u>4 1/2</u> (size) if telescope see back.			
(5) screen _____ (length) (depth to top)			
(size) _____ (material)			
(6) pump <u>1/2 sub 8</u> (HP) (yield gpm)			
<u>ELECTRIC</u> (type power)			
(7) electric log _____ (yes or no)			
(organization running log)			
(8) how well bottom plugged <u>OPEN</u>			
DRILLERS REMARKS:			


CODED

DECEMBER 10 1975

MISS. Bd. OF WATER COMM.

If well telescopes please sketch and show depths.

GROUND LEVEL

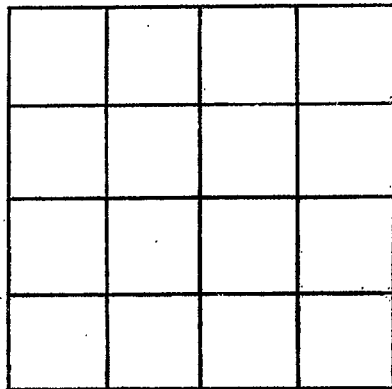

SECTION _____

Please indicate well location X.

ADDITIONAL INFORMATION

If more than one screen,
show locations of each on sketch.