

Newton
G 54
9-22-75

MISSISSIPPI
BOARD OF WATER COMMISSIONERS
416 North State Street
Jackson, Mississippi 39201

CODED

WATER WELL DRILLERS LOG

9.22.75 19 McDONALD HIZL NEWTON
date well completed firm name county well located

LANDOWNER:
ESTELLE HARRIS
DECATUR MISS
(mailing address)

description of formations encountered	from	to
<u>Clay sand</u>	<u>0</u>	<u>26</u>
<u>shale</u>	<u>26</u>	<u>60</u>
<u>Red soil shale</u>	<u>60</u>	<u>85</u>
<u>hard white shale</u>	<u>85</u>	<u>140</u>

WELL LOCATION:
sec. 17 T. 7 N. R. 12 E. 13 P.
S. W.
1 miles EAST of DECATUR
(distance) (direction) (nearest town)

WELL PURPOSE: WATER
(home, irrigation, municipal, industrial)

- WELL COMPLETION DATA:
- (1) diameter (inches) 4"
 - (2) total depth (feet) 140'
 - (3) static water level (feet) 25' below top of ground.
 - (4) casing PVC, 58'
(material) (depth)
4"
(size) If telescope see back.
 - (5) screen _____
(length) (depth to top)
(size) (material)
 - (6) pump 1/2 546 10
(HP) (yield gpm)
E
(type power)
 - (7) electric log _____
(yes or no)
(organization running log)
 - (8) how well bottom plugged OPEN

CODED


DECEASED
WILLIAM HARRIS
1917

SEP 20 1975

DRILLERS REMARKS:

If well telescopes please sketch and show depths.

GROUND LEVEL

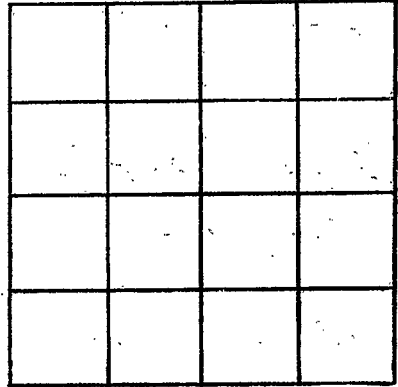

SECTION _____

Please indicate well location X.

ADDITIONAL INFORMATION

If more than one screen,
show locations of each on sketch.