

NEWTON
G 55
9-10-75

MISSISSIPPI
 BOARD OF WATER COMMISSIONERS
 416 North State Street
 Jackson, Mississippi 39201

(CODED)

CODED

WATER WELL DRILLERS LOG

9-10 1975 Commod Drilling Service Newton
 date well completed firm name county well located

LANDOWNER: Art Bailey
Rt 2 Deaturie Miss
 (mailing address)

WELL LOCATION:
 sec. 2 T. 2 N. R. 12 E.
1 miles S.E. of Deaturie
 (distance) (direction) (nearest town)

WELL PURPOSE:
 (home, irrigation, municipal, industrial)

- WELL COMPLETION DATA:
- diameter (inches) 4"
 - total depth (feet) 320
 - static water level (feet) 78 below above top of ground.
 - casing P.V.C. 115'
(material) (depth)
(size) If telescope see back.
 - screen None
(length) (depth to top)
(size) (material)
 - pump 1/2 10
(HP) (yield gpm)
Electric
(type power)
 - electric log (yes or no)
(organization running log)
 - how well bottom plugged

description of formations encountered	from	to
Clay	0	55
Sand	55	72
Clay	72	86
Sand + Clay	86	104
Clay	104	130
Sand	130	170
Wack + Clay	170	300
Sand	300	320


(CODED)

MISSISSIPPI
 BOARD OF WATER COMMISSIONERS
 416 NORTH STATE STREET
 JACKSON, MISSISSIPPI 39201

DRILLERS REMARKS:

If well telescopes please sketch and show depths.

GROUND LEVEL

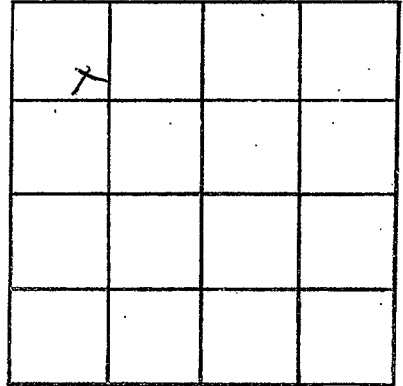

SECTION 20

Please indicate well location X.

ADDITIONAL INFORMATION

If more than one screen,
show locations of each on sketch.