

MISSISSIPPI DEPARTMENT OF NATURAL RESOURCES

Bureau of Land and Water Resources

Southport Mall

P.O. Box 10631

Jackson, Mississippi 39209

WATER WELL DRILLERS LOG

NEWTON
 656
 5-9-85

5-9-85 date well completed McDONALD + HILL firm name NEWTON county well located

LANDOWNER: TERRY MAJURE
R#2 DECATUR
 (mailing address)

WELL LOCATION:
 sec. 24 T. 70 S. R. 12 E. W.
1/2 miles EAST of DECATUR
 (distance) (direction) (nearest town)

WELL PURPOSE: HOME
 (home, irrigation, municipal, industrial)

WELL COMPLETION DATA:

(1) diameter (inches) 4"

(2) total depth (feet) 200'

(3) static water level (feet) 122' below above top of ground.

(4) casing PVC 130'
 (material) (depth)
 (size) if telescope see back.

(5) screen _____
 (length) (depth to top)
 (size) (material)

(6) pump 1/2 4
 (HP) (yield gpm)
 (type power)

(7) electric log _____
 (yes or no)
 (organization running log)

(8) how well bottom plugged OPEN

description of formations encountered	from	to
SAND	0	16
CLAY SAND	16	60
SHALE SAND	60	95
SOFT SHALE	95	116
MED SHALE	116	140
LIME ROCK ST SHALE	140	160
SAND BT LIME ROCK	160	200

RECEIVED
 MAY 16 1985


Department of Natural Resources
 Bureau of Land & Water Resources

DRILLERS REMARKS:
SET PUMP 140'

JM

If well telescopes please
sketch and show depths.

GROUND LEVEL

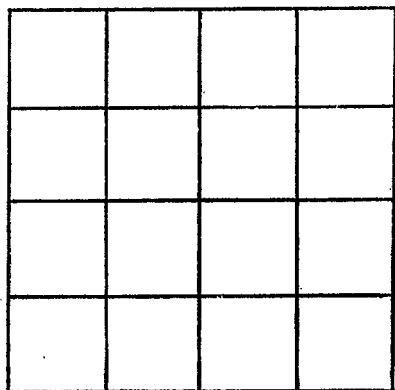

SECTION _____

Please indicate well location X.

ADDITIONAL INFORMATION

If more than one screen,
show locations of each on sketch.