


Newton
 G 2001
 10-23-75

MISSISSIPPI
 BOARD OF WATER COMMISSIONERS
 416 North State Street
 Jackson, Mississippi 39201

WATER WELL DRILLERS LOG

10, 23, 75 date well completed
 McDONALD & HILL firm name
 NEWTON county well located


LANDOWNER:	description of formations encountered	from	to
PAT HARRIS			
PAT 2 DECATUR (mailing address)	Sand	16	60
WELL LOCATION: sec 7 T 10N R 12E 13P	Soft sand	60	80
1/2 miles NORTH of DECATUR (distance) (direction) (nearest town)	Shale	80	120
WELL PURPOSE: (home, irrigation, municipal, industrial)	Red sandstone	120	130
WELL COMPLETION DATA:	Sand	130	140
(1) diameter (inches) 4"	Sandy	140	150
(2) total depth (feet) 180'	Sand	150	180
(3) static water level (feet) 55' below top of ground.			
(4) casing PVC 115' (material) (depth)			
4" (size) if telescope see back.			
(5) screen (length) (depth to top)			
(size) (material)			
(6) pump 1/2 (HP) 10 (yield gpm)			
E (type power)			
(7) electric log (yes or no)			
(organization running log)			
(8) how well bottom plugged ODEY			
DRILLERS REMARKS:			

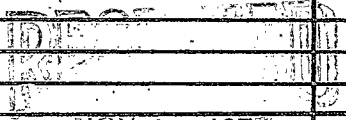

NOV 3 1975

If well telescopes please sketch and show depths.

GROUND LEVEL

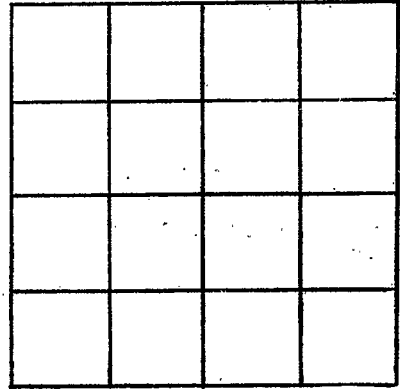

SECTION _____

Please indicate well location X.

ADDITIONAL INFORMATION

If more than one screen, show locations of each on sketch.