

Newton
G 2002
12-9-75

MISSISSIPPI
 BOARD OF WATER COMMISSIONERS
 416 North State Street
 Jackson, Mississippi 39201

WATER WELL DRILLERS LOG

12-9-75 19 McDONALD + HILL NEWTON
 date well completed firm name county well located


LANDOWNER:	description of formations encountered	from	to
<u>ROBERT DEARSON</u>			
<u>RH1 DECATUR</u> (mailing address)	<u>Shel.</u>	<u>15</u>	<u>60</u>
WELL LOCATION:	<u>sand</u>	<u>60</u>	<u>140</u>
sec. <u>31</u> T. <u>7N</u> R. <u>12E</u>	<u>Soft shale</u>	<u>140</u>	<u>150</u>
<u>1 1/2</u> miles <u>SOUTH</u> of <u>Decatur</u> (distance) (direction) (nearest town)	<u>Shale</u>	<u>150</u>	<u>194</u>
WELL PURPOSE: <u>FOR ANNUAL</u> (home, irrigation, municipal, industrial)	<u>Part shell</u>	<u>104</u>	<u>218</u>
WELL COMPLETION DATA:	<u>sand</u>	<u>210</u>	<u>240</u>
(1) diameter (inches) <u>4 1/2"</u>			
(2) total depth (feet) <u>240</u>			
(3) static water level (feet) <u>100</u> below top of ground.			
(4) casing <u>PVC</u> <u>165'</u> (material) (depth)			
<u>4 1/2"</u> if telescope see back. (size)			
(5) screen _____ (length) (depth to top)			
(size) (material)			
(6) pump <u>1/2 sub 6</u> (HP) (yield gpm)			
<u>E</u> (type power)			
(7) electric log _____ (yes or no)			
(organization running log)			
(8) how well bottom plugged <u>OPEN</u>			
DRILLERS REMARKS:			
<u>SPT PUMP 100</u>			



DEC. 29 1975

If well telescopes please sketch and show depths.

GROUND LEVEL

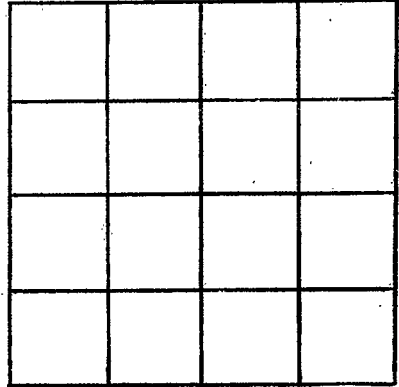

SECTION _____

Please indicate well location X.

ADDITIONAL INFORMATION

If more than one screen, show locations of each on sketch.