

Newton  
G 2003  
12-11-75

MISSISSIPPI  
 BOARD OF WATER COMMISSIONERS  
 416 North State Street  
 Jackson, Mississippi 39201

WATER WELL DRILLERS LOG


12-11-75 19 McDonald + Hill NEWTON  
 date well completed firm name county well located

LANDOWNER:	description of formations encountered	from	to
<u>WAYNE ROBINSON</u>	<u>Clay</u>	<u>0</u>	<u>16</u>
<u>Rt 2 DECATUR</u> (mailing address)	<u>sand</u>	<u>16</u>	<u>54</u>
WELL LOCATION:	<u>Soft shale</u>	<u>54</u>	<u>72</u>
sec. <u>35</u> T. <u>7</u> N R. <u>12</u> E S W	<u>Shale</u>	<u>72</u>	<u>108</u>
<u>4</u> miles <u>NORTH</u> of <u>Hickory</u> (distance) (direction) (nearest town)	<u>Rock shale</u>	<u>108</u>	<u>130</u>
WELL PURPOSE: <u>for use</u> (home) irrigation, municipal, industrial	<u>loam sand</u>	<u>130</u>	<u>145</u>
WELL COMPLETION DATA:	<u>Rock shale</u>	<u>145</u>	<u>290</u>
(1) diameter (inches) <u>4"</u>	<u>sand</u>	<u>290</u>	<u>330</u>
(2) total depth (feet) <u>330'</u>			
(3) static water level (feet) <u>108'</u> below top of ground.			
(4) casing <u>PVC</u> <u>104'</u> (material) (depth)			
<u>4"</u> (size) if telescope see back.			
(5) screen _____ (length) (depth to top)			
(size) _____ (material) _____			
(6) pump <u>1/2 sub 6</u> (HP) (yield gpm)			
<u>E</u> (type power)			
(7) electric log _____ (yes or no)			
(organization running log) _____			
(8) how well bottom plugged <u>OPEN</u>			
DRILLERS REMARKS:			

MISS. Bd. OF WATER COMMISSIONERS  
 DEC 26 1975

If well telescopes please  
sketch and show depths.

GROUND LEVEL

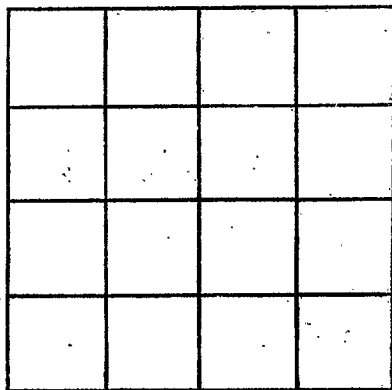

SECTION \_\_\_\_\_

Please indicate well location X.

ADDITIONAL INFORMATION

If more than one screen,  
show locations of each on sketch.