

Newton
 G 2004
 1-29-76

MISSISSIPPI
 BOARD OF WATER COMMISSIONERS
 416 North State Street
 Jackson, Mississippi 39201

WATER WELL DRILLERS LOG

1-29-76 19 McDonald + 1416 NEWTON
 date well completed firm name county well located

LANDOWNER:
 CHARLES M HARRIS
 RR 2 DECATOR
 (mailing address)

WELL LOCATION:
 sec. 9 T. 7 N R. 15 E
 2 miles N EAST of DECATOR
 (distance) (direction) (nearest town)

WELL PURPOSE:
 (home, irrigation, municipal, industrial)

WELL COMPLETION DATA:
 (1) diameter (inches) 4"
 (2) total depth (feet) 2100'
 (3) static water level (feet) 120' below top of ground.
 (4) casing PVC 152' (material) (depth)
 4" (size) if telescope see back.
 (5) screen (length) (depth to top)
 (size) (material)
 (6) pump 1/2 sub 6 (HP) (yield gpm)
 E (type power)
 (7) electric log (yes or no)
 (organization running log)
 (8) how well bottom plugged OPEN

description of formations encountered	from	to
Clay Sand	0	32
Shale	32	63
Rock & sand	63	72
Clay & Rock	72	90
Yellow Sand	90	112
Soft shale	112	120
Shale & Rock	120	160
White sand	160	165
Rock	165	167
Rock shale	167	215
Sand	215	220
Shale	220	232
Sand	232	210


DRILLERS REMARKS:

FEB 4 - 1976

MISS. BD. OF WATER COMM

If well telescopes please sketch and show depths.

GROUND LEVEL

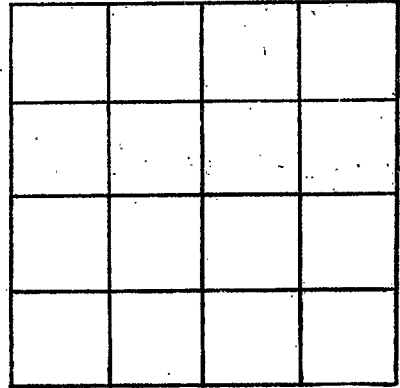

SECTION _____

Please indicate well location X.

ADDITIONAL INFORMATION

If more than one screen,
show locations of each on sketch.